

FORM 51


Finney

KANSAS

Section 33 Township 22 Range 33W

Well No. 8 Damme

Company W. L. Hartman

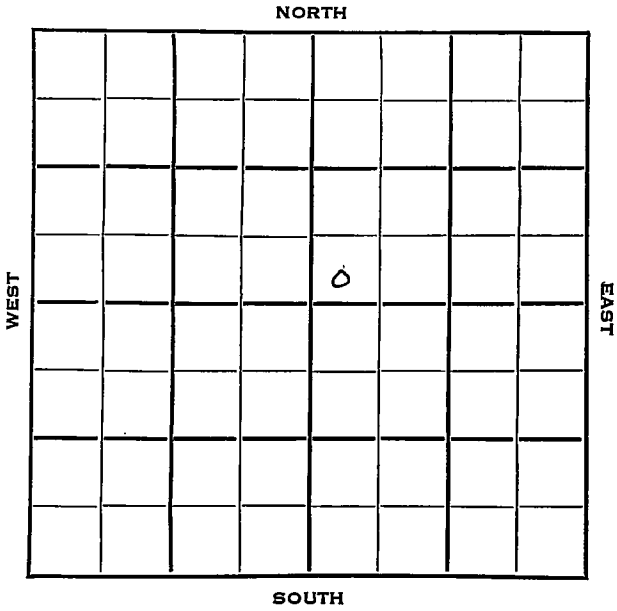

Sec. 33 Twp. 22 R. 33W

Well No. #8 Damme Farm

W. L. Hartman Company

S. Damme Pool Contractor


Ft. from N. Line

330 Ft. from S. Line

Ft. from E. Line

330 Ft. from W. Line

SW SW NE

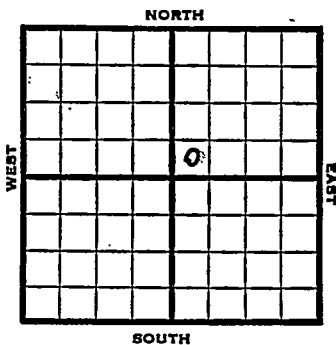

1952<sup>E</sup> Lev. 2879' REPORT

|       |   |
|-------|---|
| 12/17 | 10" @ 250<br>Drlg. 2300'  |
| 12/25 | Drlg 2300   |
| 1/1   | Hol 2504 Her 2533 Kr. 2554<br>Win 2593 RTD 2706 7" @ 2706   |
| 1/8   | NR  |
| 1/22  | "   |
| 1/29  | NR  |
| 2/5   | NR  |
| 2/12  | "   |
| 2/19  | "   |
| 2/26  | N. R.   |
| 3/12  | "   |
| 3/19  | NR  |
| 3/26  | NR  |
| 4/2   | "   |
| 4/9   | NR  |
| 4/16  | "   |
| 4/22  | Gas Well<br>TD 2706<br>10" @ 250<br>Hol 2504, Her 2533, Kri 2554, Win 2593<br>TD 2706<br>7" @ 2706<br>Comp. 539,000 gas, 415# |

COMPLETED

County Finney State Kansas  
 Sec. 33 (Blk. Twp.) 22 (Sur. Rge.) 33W Map No.  
 Operator W. L. Hartman  
 Well No. 8 Farm Damme  
 Elev. Location SW SW NE

|  |  |  |  |  |  |
|--|--|--|--|--|--|
|  |  |  |  |  |  |
|  |  |  |  |  |  |
FIRST REPORT  
 0

330 Ft. From S Line NE  
330 Ft. From W Line Quarter  
 1st. Report DEC 17 1952  
 Completion \_\_\_\_\_  
 Remarks \_\_\_\_\_  
 Spudding Date \_\_\_\_\_

Drlg. Data S. Damme Pool  
10" @ 250 drlg. 2300

