


Section 33 Township 22 Range 3 6W

Well No. #1 Kellman

Company Beymer Drlg.

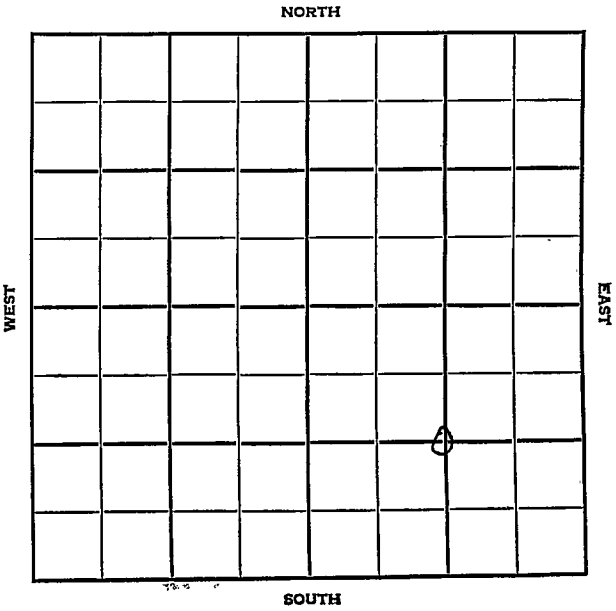

Kearny KANSAS

SEC.	TWP.	R.
33	22	36 W ✓

WELL NO. # 1 Kleeman FARM

CONTRACTOR Beymer Drlg.

Burris


Hugoton Pool
Ft. from N. Line

1320 Ft. from S. Line

1320 Ft. from E. Line

Ft. from W. Line

C SE/4

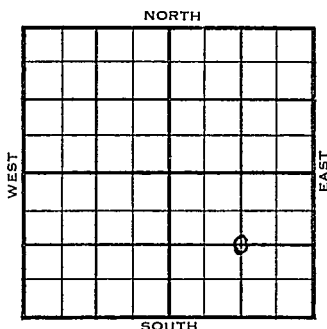


1954	ELEVATION 3199'	REPORT
------	-----------------	--------

5/12 Location

5/19 8" @ 260' w/150 sks
Drlg 1920'

6/2 Spud 5-12-54 Gas well TD 2638
8-5/8" @ 260 Her-kri. 2606
TD 2607 B. Kri. 2638 DD 2638
5" @ 2605 frac. 6000 A
Comp. 3,500,000 gas. 370#

COMPLETED

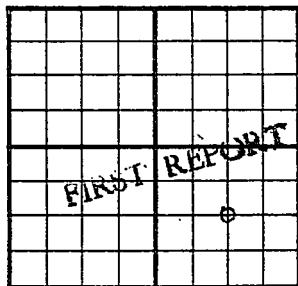County Kearny State KansasSec. 33 (Bk. Twp.) 22 (Sur. Rge.) 36W Map No.Operator Beymer Drlg.Well No. 1 Farm KleemanElev. Location C SE/41320 Ft. From S Line SE1320 Ft. From E Line Quarter1st. Report MAY 12 1954

Completion


Remarks

Burris - Contr.

Spudding Date

Drlg. Data Hugoton PoolLocation

County Kearny State Kansas
 Sec. 33 (Bk.) 22 (Sur.) 36W Map No.
 Operator Beymer Drlg.
 Well No. 1 Farm Kleeman
 Elev. 3199 Location C SE/4

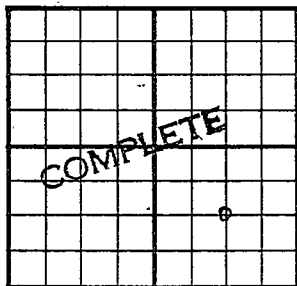

1320Ft. From S Line SE
1320Ft. From E Line Quarter
 Ist. Report
 Completion JUN 2 1954
 Remarks Hugoton Pool
Burris - Contr.
 Spudding Date 5-12-54

Drlg. Data Gas well TD 2638
8 5/8" @ 260 Her.-Kri? 2606 . TD 2607
B. Kri? 2638 DD 2638 5" @ 2605 frac
6000 A Comp. 3,500,000 gas 370#