#1 Smith C SE SE Sec. 18 Lee Banks & Beacon Resources

Township 22, Range 34 W, County Finney, State Kansas,

Red Tiger Drilling Co.

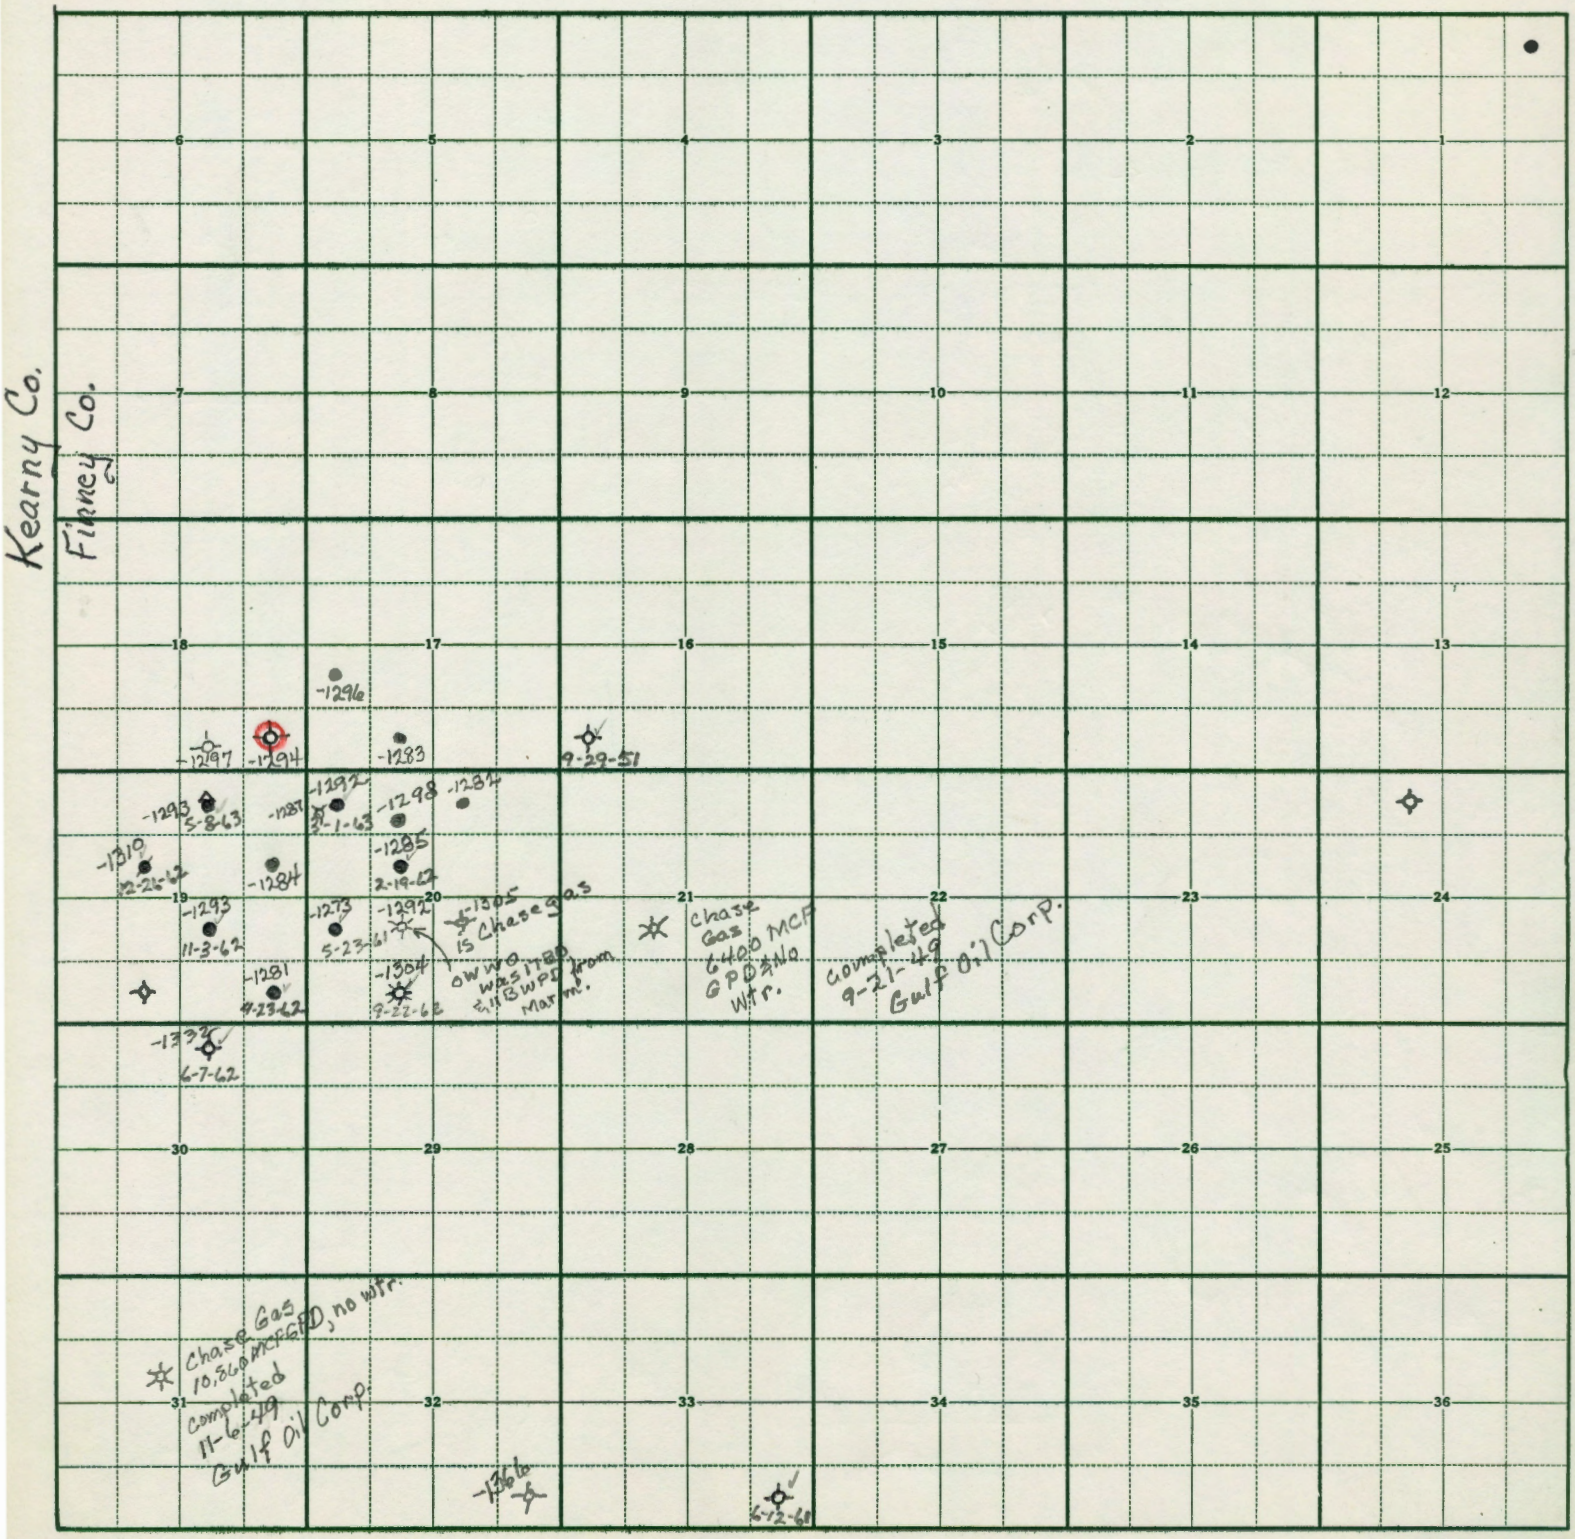

FORM 50 F

KANSAS BLUE PRINT CO. INC.
BLUE PRINTING • PHOTOSTAT WORK • OIL MAP FORMS
ARCHITECTS AND ENGINEERS SUPPLIES
Phone NO 4-9344
117 North Market St.-Wichita 1, Kansas