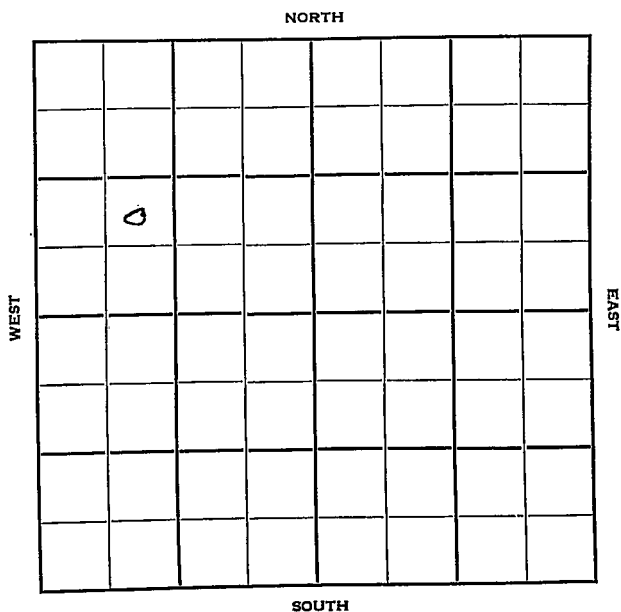


Section 34 Township 22 Range 13WWell No. #2 HarrisCompany Westgate-Greenland

Stafford

KANSAS

Sec. 34 Twp. 22 R. 15W

Well No. # 2 Harris Farm

Westgate-Greenland Company

Drlg. Corp. Contractor


 Ft. from N. Line

990 Ft. from S. Line

 Ft. from E. Line

990 Ft. from W. Line

NE SW NW

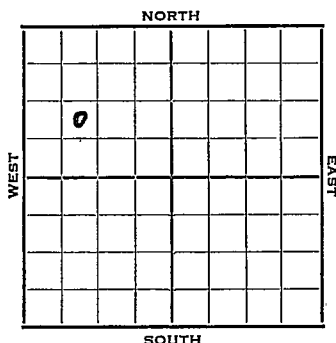

1952	Elev. 1910' REPORT
10/29	Spud 10-24-52 8" @ 295 Anhy 765' Drlg. 2486'
11/5	Heeb 3292', Br li 3425', Lans 3424 DST 3502-43, 1 hr., 175' SW 990# DST 3613-20, 1 hr., 12' M 110# BKC 3701', V 3742, Simp 3803, Arb 3855' Drlg. 3862'
11/12	Spud 10-24-52 D&A TD 3882' 8" @ 295 Anhy 765, Heeb 3292, Br. lime 3425, Lans 3434 DST 3502-43, opn 1 hr., rec. 175' sw 990# DST 3613-20, opn 1 hr., rec. 12' mud 110# B KC 3701, Viola 3742, Simp 3803, Arb 3855 TD 3882 D&A

ABANDONED

County Stafford State Kansas

Sec. 34 (Blk.) 22 (Sur.) 13W Map No.

Operator Westgate-Greenland

Well No. **2** Farm **Harris**

Elev.	Location	NE	SW	NW
-------	----------	----	----	----

990 Ft. From S Line NW

990 Ft. From W Line Quarter

1st. Report OCT 29 1952

Completion _____

Remarks

Brig. Corp - Contr.

Spudding Date **10-24-52**

Drlg. Data


8th @ 295 Anhy 765 drlg. 2486

County Stafford State Kansas
 Sec. 34 (Blk.) 22 (Sur.) 13W Map No.

Operator Westgate-Greenland

Well No. 2 Farm Harris

Elev. 1910 Location NE SW NW

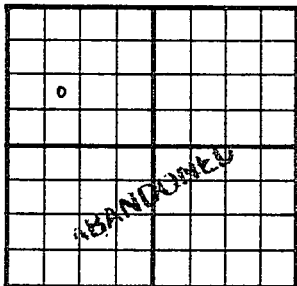

990 Ft. From S Line NW

990 Ft. From W Line Quarter

1st. Report

Completion NOV 12 1952

Remarks

Drlg. Corp. - Contr.

Spudding Date 10-24-52

Drlg. Data D & A TD 3882

8" @ 295 Anhy 765 Heeb. 3292

Br. lime 3425 Lans. 3434 DST 3502-43

open 1 hr. Rec. 175' sw 990#

DST 3613-20 open 1 hr. Rec. 12' mud

110# B KC 3701 Viola 3742 Simp. 3803

Arb. 3855 TD 3882

D & A

J. G. McGEHEE