


Stafford

KANSAS

Section 34 Township 22 Range 13W

Well No. #1 Harris

Company Jackson Drilg. Corp.

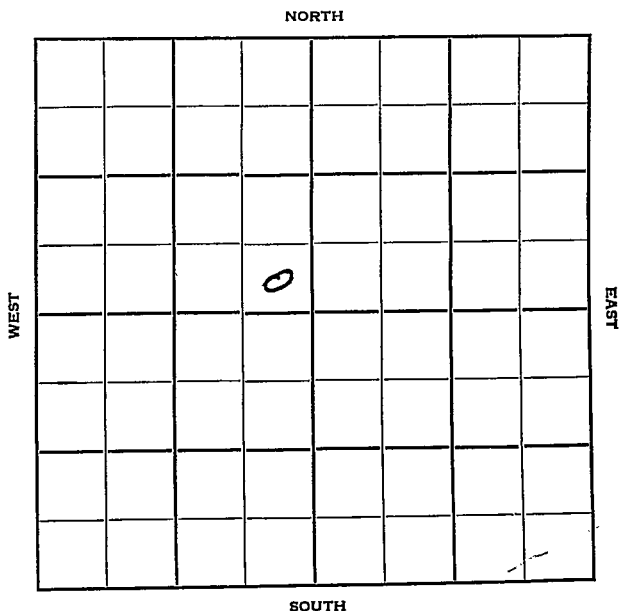

Stafford

KANSAS

Sec. 34 Twp. 22 R. 13 W

Well No. # 1 Harris Farm

Jackson Drlg. Corp. Company

Jackson Contractor

Wildcat


 Ft. from N. Line

330 Ft. from S. Line

330 Ft. from E. Line

 Ft. from W. Line

SE SE NW

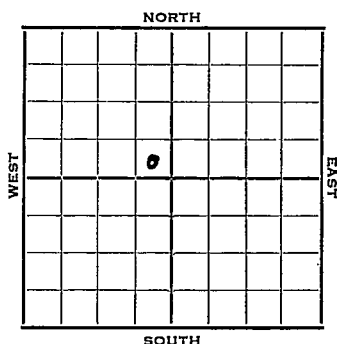

1952

REPORT

7/16 Location

7/23 8" @ 271

D Drlg. 2560'

7/30 Heeb. 3283 Br Li 3418

Lans. 3442

DST 3456-86, 1 hr. 20' m 10' SO&GCM

EST 3556-84, 1 hr. 210' gas 60' O&GCM

O# DST 3588-3607, 1 hr. 38'm SO

1100# BKC 3666 Marm 3672

SSul wtr. 1250# TD 3898' Schl.

8/6 Spud 7-16-52

D&A TD 3898

8" @ 271 Heeb. 3283

Br lime 3418 Lans. 3442

DST 3456-86 opn 1 hr.

Rec. 20' mud 10' so&gcm O#

DST 3556-84 opn 1 hr. Rec. 210' gas

60' o & gcm O# DST 3588-3607

opn 1 hr. Rec. 38' mud 1100#


BKC 3666 Marm 3672 Viola 3739

Simp 3803 Arb. 3851

DST 3852-63 opn 1 hr. Rec. 1560' sul

wtr 1250# TD 3898 D&A

ABANDONED

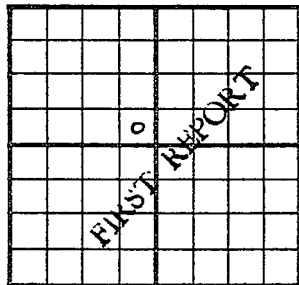County Stafford State KansasSec. 34 (Blk. Twp.) 22 (Sur. Rge.) 13W Map No.Operator Jackson Drlg. Corp.Well No. 1 Farm HarrisElev. _____ Location SE SE NW330 Ft. From S Line NW330 Ft. From E Line Quarter1st. Report JUL 16 1952

Completion _____

Remarks _____


Jackson - Contr.

Spudding Date _____

Drlg. Data _____

WildcatLocation

J. G. McGEHEE

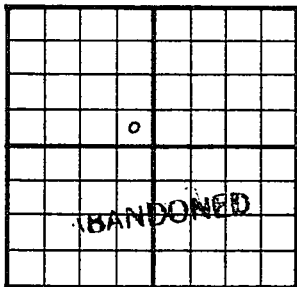County Stafford State KansasSec. 34 (Blk.
Twp.) 2 2 (Sur.
Rge.) 13W Map No.Operator Jackson Drlg.Well No. 1 Farm HarrisElev. 1899 Location SE SE NW330 Ft. From S Line NW330 Ft. From E Line Quarter1st. ReportCompletion AUG 6 1952Remarks WildcatJackson Drlg. - Contr.Spudding Date 7-16-52Drlg. Data D & A TD 38988" @ 271 Heeb. 3283 Br. lime 3418Lans. 3442 DST 3456-86 open 1 hr.Rec. 20' mud 10' so & gcm 0#DST 3556-84 open 1 hr. Rec. 210' gas60' o & gcm 0# DST 3588-3607 open 1 hRec. 38' mud 1100# B KC 3666Marm. 3672 Viola 3739 Simp. 3803Arb. 3851 DST 3852-63 open 1 hr.Rec. 1560' sul water 1250# TD 3898D & A

J. G. McGEHEE