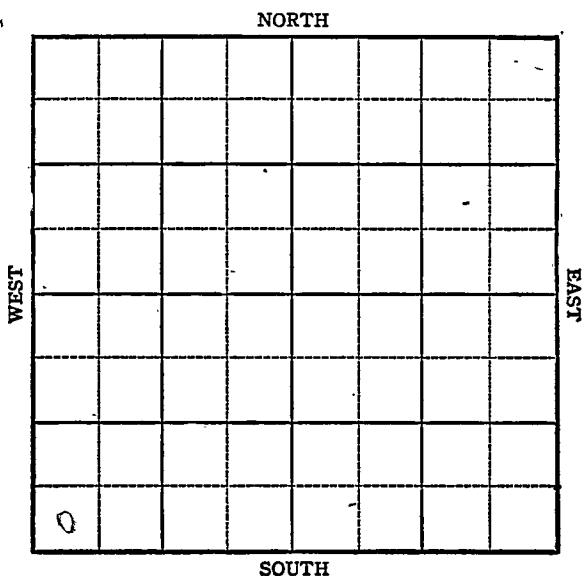


KANSAS

Reno

Section 34 Township 22 Range 8WWell No. #1 OsenbaughCompany Sterling Drlg.

KANSAS

Reno

34

22

8W

Sec. _____ Twp. _____ R. _____

#1 Osenbaugh

Well No. _____ Farm _____

Sterling Drlg.

Company _____

Wildcat

_____ Ft. from N. Line

330


_____ Ft. from S. Line

_____ Ft. from E. Line

330

_____ Ft. from W. Line

SW/c

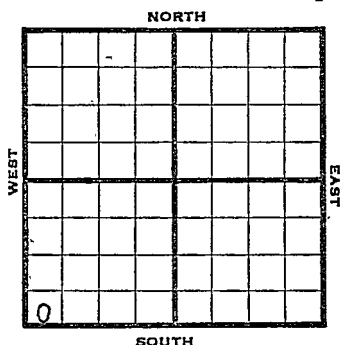

1944

R E P O R T

12/20

Location

12/29

10" @ 160' Drlg. 2545'

1945

1/3

Lans 3092 Drlg 3400

1/10

Cong 3613

Miss 3623

Misener 3927

Viola 3929

Arb 4047

Drlg 4057

1/17

Simp 3961

Arb 4047


TD 4080

ABANDONED

Pool Name WildcatMap No. 49 Sec. 34 Twp. 22 R. 8WWell No. 11 OsenbaughSterling Drlg. CompanyFIRST REPORT Contractor

SW/c

SECTION PLAT

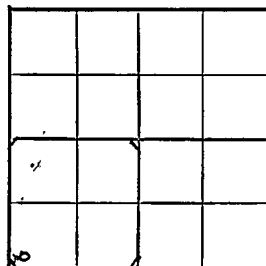 Ft. from N. Line330 Ft. from S. Line Ft. from E. Line330 Ft. from W. LineRenoLocation XRig up

Drilling and Remarks:

RECORD

Cased in., ft.Sand Gas Oil Total Depth

PRODUCTION

1st 24 hrs. Nat. 1st 24 hrs. after shot Gas Cu. Ft.Dry Hole Abandoned

Date

DEC 20 1944 19 S. J. LEWIS Scout

KANSAS

Pool Name WildcatMap No. _____ Sec. 34 Twp 22 R 8WWell No. 1 OsenbaughSterling Drlg.

Company

ABANDONED

Contractor

SW/c

SECTION PLAT

_____ Ft. from N. Line

330 Ft. from S. Line

_____ Ft. from E. Line

330 Ft. from W. Line

Rer o

Location _____

Rig up _____

Drilling and Remarks:

Surf 3961
Re 84047

RECORD

Cased _____ in., _____ ft.

Sand _____

Gas _____

Oil _____

Total Depth 4080

PRODUCTION

1st 24 hrs. Nat. _____

1st 24 hrs. after shot _____

Gas _____ Cu. Ft.

Dry Hole _____

Abandoned _____

Date

JAN 17 1945

19

S. J. LEWIS Scout