

KANSAS


FORM 51 5M 1-42 PETROL

Reno

Section 34 Township 22 Range 8-W

Well No. #1 Wilkey

Company Herndon Drilling

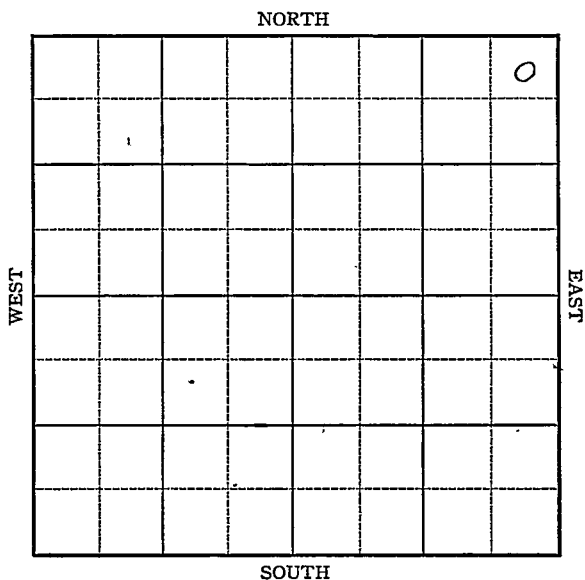

KANSAS

Reno KANSAS

Sec. 34 Twp. 22 R. 8-W

Well No. #1 Wilkey Farm

Herndon Drilling Company


Wildcat

330 Ft. from N. Line

 Ft. from S. Line

330 Ft. from E. Line

 Ft. from W. Line

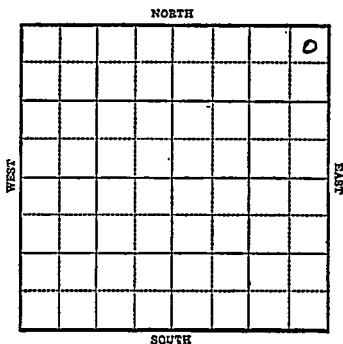

1943

R E P O R T

3/31 Derrick

4/7 8" @ 315'
Drlg. 2528'

4/14 Lans 3133
Miss 3616 SSO
B.Miss 3675
Drlg. 3757'


4/21 Viola 3915
Arb. 4020
T.D. 4056'
No shows.

ABANDONED

Map No. KANSAS Sec. 34 Twp. 22 R. 8WWell No. 1 WilkeyHerndon Drilling CompanyFIRST REPORT Contractor

NE/c

SECTION PLAT

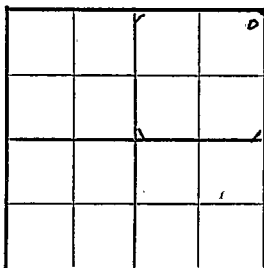330 Ft. from N. Line Ft. from S. Line330 Ft. from E. Line Ft. from W. Line

WILDCAT

Location Rig up

Drilling and Remarks:

Derrick

RECORD

Cased in., ft.Sand Gas Oil Total Depth

PRODUCTION

1st 24 hrs. Nat. 1st 24 hrs. after shot Gas Cu. Ft.Dry Hole Abandoned

Date

MAR 31 1943

19

S. J. LEWIS

Scout

KANSAS
Map No. 49 Sec. 34 Twp. 22 R. 8WWell No. 1 WilkeyHerndon Drilling Company

ABANDONED

Contractor

NE/C

330 Ft. from N. Line

Ft. from S. Line

330 Ft. from E. Line

Ft. from W. Line

SECTION PLAT

			o

WILDCA T

Location

Rig up

Drilling and Remarks:

*Vid'la 8915**Cr X 4020**Noshows*

RECORD

Cased _____ in., _____ ft.

Sand _____

Gas _____

Oil _____

Total Depth 4056

PRODUCTION

1st 24 hrs. Nat. _____

1st 24 hrs. after shot _____

Gas _____ Cu. Ft.

Dry Hole _____

Abandoned _____

Date

APR 21 1943

19

S. J. LEWIS Scout