

Reno

KANSAS

FORM 51

Section 34 Township 22 Range 10WWell No. 1 TrétbarCompany M.B. Armer

NORTH

							0

SOUTH

WEST


EAST

KANSAS ✓

Reno

Sec. 34 Twp. 22 R. 10WWell No. 1 Tretbar FarmM.B. Armer CompanyPrime Drlg - Contr. ContractorWildcat Ft. from N. Line330 Ft. from S. Line330 Ft. from E. Line Ft. from W. Line

SE SE SE

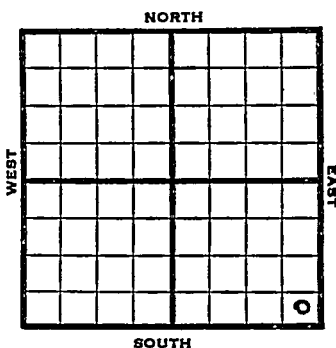

1953

Elev. 1754'

REPORT

4/1

Spud 3-25-53

8" @ 250

Drlg 2625

4/2

NR

4/9

Lans 3194, V. 3585, Simp 3645

DST 3663-70, 1½ hrs., 180' wtr.

1140#

Drlg. 3685'

4/15

Spud 3-25-53

D&A

TD 3730

8" @ 250

Lans 3194, V. 3585, Simp 3645

DST 3663-70, opn 1½ hrs., rec. 180'

wtr., 1140#


Arb. 3713

TD 3730

D&A

ABANDONED


County Reno State Kansas
 Sec. 34 (Blk.) 22 (Sur.) 10W Map No.
 Operator M. B. Armer
 Well No. 1 Farm Tretbar
 Elev. _____ Location SE SE SE

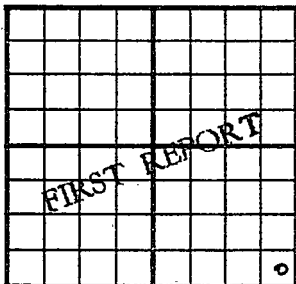

330 Ft. From S Line SE
330 Ft. From E Line Quarter
 1st. Report APR 1 1953
 Completion _____
 Remarks Prime Drlg. - Contr.
 Spudding Date 3-25-53

Drlg. Data Wildcat

8" @ 250 drlg. 2625

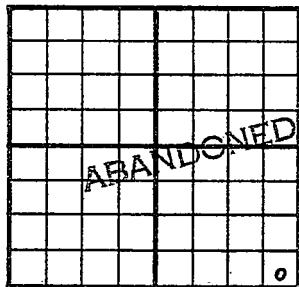County Reno State KansasSec. 34 (Blk.
Twp.) 22 (Sur.
Rge.) 10W Map No.Operator M. B. ArmerWell No. 1 Farm TretbarElev. 1754 Location SE SE SE330 Ft. From S Line SE330 Ft. From E Line Quarter

1st. Report

Completion APR 15 1953Remarks Wildcat

Prime Drlg. - Contr.

Spudding Date 3-25-53Drlg. Data D & A TD 37308" @ 250 Lans. 3194 Viola 3585Simp. 3645 DST 3653-70 open 1 $\frac{1}{2}$ hr.Rec. 180' wtr. 1140# Arb. 3713TD 3730D & A