


Section 34 Township 22 Range 16WWell No. 1 B HarrisCompany Gulf

Shady Creek Pool

NORTH

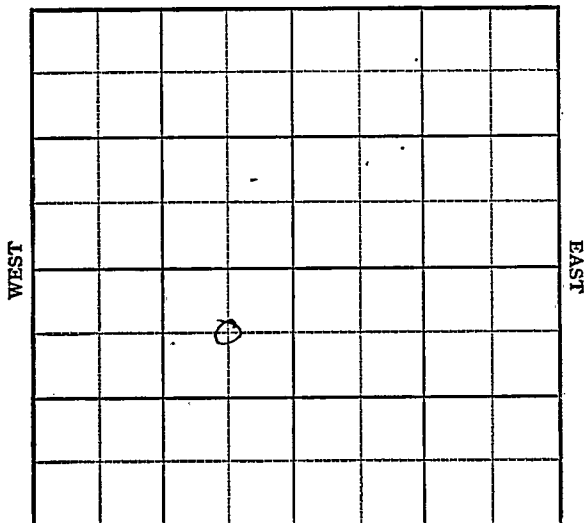

SOUTH

Sec. 34 Twp. 22 R. 16W ✓

Well No. 1 B. Harris Farm

Gulf Company

Shady Creek Pool


660 Ft. from N. Line

Ft. from S. Line

660 Ft. from E. Line

Ft. from W. Line

C NE SW

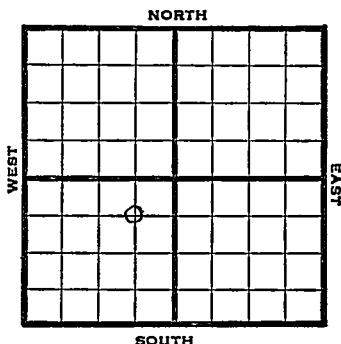

1948

Eli 2061' REPORT

9/1 RUR

9/8 8" @ 1039'  
Drlg. 1045'

9/14 Lansing 3658'  
Viola 4024'  
Drlg. 4048'

9/21 Arbuckle 4130'  
TD 4156' wtr  
SD

9/29 TD 4156'  
Arb. 4130'

**ABANDONED**

Pawnee County Kansas State

Map No. \_\_\_\_\_ Sec. 34 Twp. 22 R. 16W

Well No. 1 B. Harris

Gulf Company

FIRST REPORT Contractor

C NE SW

### SECTION PLAT

|  |  |  |  |  |  |  |  |
|--|--|--|--|--|--|--|--|
|  |  |  |  |  |  |  |  |
|  |  |  |  |  |  |  |  |
660 Ft. from N. Line

\_\_\_\_\_ Ft. from S. Line

660 Ft. from E. Line

\_\_\_\_\_ Ft. from W. Line

Shady Creek Pool

Remarks:

R U R

Date

SEP 1 1948

Scout

S. J. LEWIS

Map No. 81 Sec. 34 Twp. 22 R. 16WWell No. 1 B. HarrisGulf

Company

**ABANDONED**

Contractor

C NE SW

E12061  
SECTION PLAT660 Ft. from N. Line         Ft. from S. Line660 Ft. from E. Line         Ft. from W. Line

|  |   |   |  |
|--|---|---|--|
|  |   |   |  |
|  |   |   |  |
|  | o | . |  |
|  |   |   |  |

Pawnee County

Location                         Rig up                         

Drilling and Remarks:

Cor 84130

## RECORD

Cased          in.,          ft.Sand                         Gas                         Oil                         Total Depth 4456

## PRODUCTION

1st 24 hrs. Nat.                         1st 24 hrs. after shot                         Gas                          Cu. Ft.Dry Hole                         Abandoned                         

Date

SEP 29 1948 19' S. J. LEWIS Scout