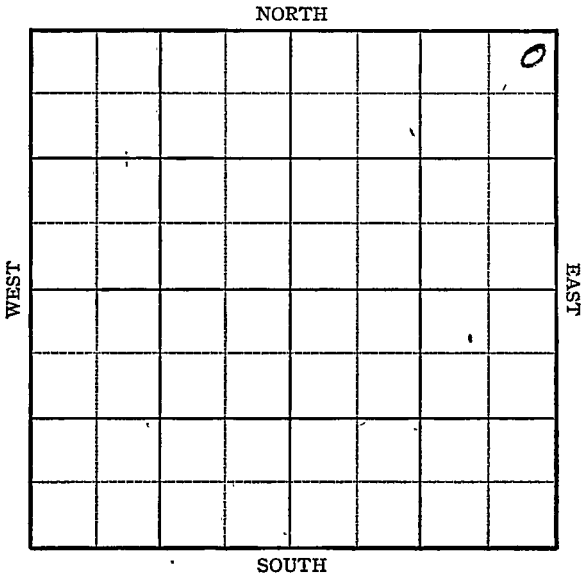


FORM 51 5M PETROL

Section 34 Township 22 Range 16WWell No. 1 KatchlemanCompany Hubert Kiowa Drlg.

Sec. 34 Twp. 22 R. 16-W

Well No. #1 Katchleman Farm

Hubert Kiowa Drlg. Company

Wildcat


330 Ft. from N. Line

Ft. from S. Line

330 Ft. from E. Line

Ft. from W. Line

NE/c Elev. 2044

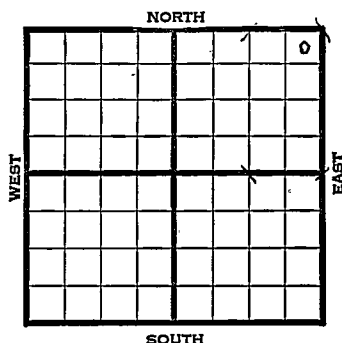

1945 REPORT

7/3	Cellar	Stanolind farmout
7/11	8" @ 720	
	Drlg. 2020'	
7/19	Anhy 1008	
	Heebner 3507	
	Lans 3638	
	Topeka 3127	
	TD 3692'	
7/26	Cong 3400	
	Simp 4047	
	Arb. 4059	
	5" @ 4060	
	TD 4064' RUST	8/15-500 acid swb. 28
8/17	Arbuckle 4059'	oil in 6 hrs.
	Set 5" @ 4060'	33 Gas
	TD 4064'	
	500 acid	
	Swabbed 28 bbls. oil in 6 hours	
	No water	
	Gravity 33 (Telegram)	
8/22	500 acid swb. 28 oil in 66 hrs.	
	Grav. 33	
18/29	" " " " "	
9/5	" " " " "	
9/12	Pump 55 oil in 12 hrs.	
9/19	" " " " "	
9/26	Pump 6 oil in 16 hrs. 1000 acid.	
	Testing	
10/3	Drill dep ~~se~~	

OVER

1945

- 10/10 Arb. 4078 corrected
25' of 4" liner @ 4080
4083 2 M Gas
- 10/17 Drlg. 4089
4-1/4 M Gas.
- 10/24 Drlg. 4105
- 10/31 TD 4107
35 M Gas tooks in hole.
S.D.
- 11/7 36 $\frac{1}{2}$ M Gas. 1220# R Pr.
- 11/14 Arb. 4078
5" @ 4060
25' of 4" liner @ 4080
TD 4107
36 $\frac{1}{2}$ M Gas.
1220# R Pr.

COMPLETED

Pool Name WildcatMap No. 81 Sec. 34 Twp. 22 R. 16WWell No. 1 Katchleman

Hubert Kiowa Drlg.

Company

FIRST REPORT

Contractor


NE/c

Hot File

SECTION PLAT

330 Ft. from N. Line Ft. from S. Line330 Ft. from E. Line Ft. from W. Line

Pawnee County

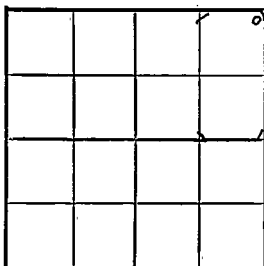Location Rig up

Drilling and Remarks:

cellar Stanolind
farmout

RECORD

Cased in., ft.Sand Gas Oil Total Depth

PRODUCTION

1st 24 hrs. Nat. 1st 24 hrs. after shot Gas Cu. Ft.Dry Hole Abandoned

Date


JUL 3 1945 19S. J. LEWIS Scout

KANSAS

Pool Name ShadyMap No. 81 Sec. 34 Twp. 22 R. 16WWell No. 1 KatchlemanHuber & Kiowa Drlg. Company**COMPLETED**

Contractor

NE/c

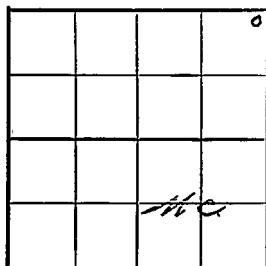E12044
SECTION PLAT550 Ft. from N. Line Ft. from S. Line330 Ft. from E. Line Ft. from W. LinePawnee CountyLocation Rig up

Drilling and Remarks:

Cor 40985' @ 406023" x 4" Liner Co.405036 1/2 M Gas1220 # R/P**RECORD**Cased in., ft.Sand Gas Oil Total Depth 4107**PRODUCTION**1st 24 hrs. Nat. 1st 24 hrs. after shot Gas Cu. Ft.Dry Hole Abandoned

Date

NOV 14 1945

19

S. J. LEWIS

Scout