


Section 34 Township 22 Range 17 W

Well No. # 1 Wyman "C"

Company Drillers Explor.

NORTH

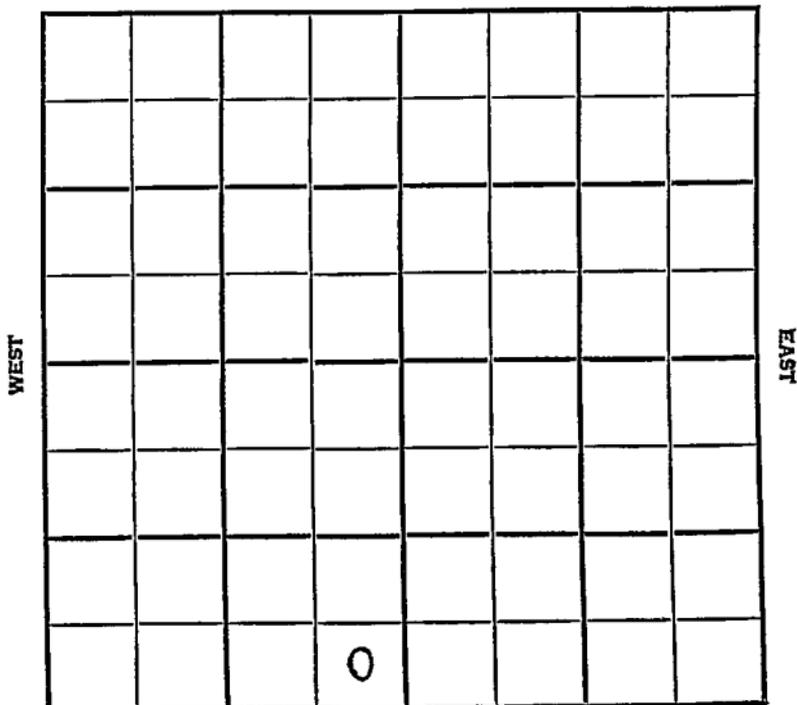

SOUTH

Pawnee KANSAS

SEC. 34	TWP. 22	R. 17W
------------	------------	-----------

WELL NO. 1 Wyman "C" FARM

COMPANY Drillers Explors.

CONTRACTOR B & B


Jab Pool

_____ Ft. from N. Line
330

_____ Ft. from S. Line
330

_____ Ft. from E. Line

_____ Ft. from W. Line

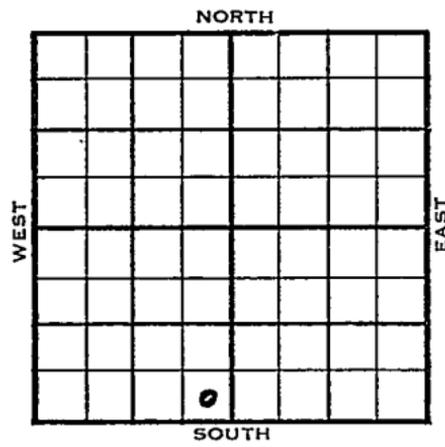

SE SE SW

1955	ELEVATION	REPORT
------	-----------	--------

2/16	Spud 2-9-55 8" @ 254' Drlg. 3090'	
------	---	--

