
Pawnee KANSAS

SECTION 34 TOWNSHIP 22 RANGE 18 ~~W~~ E

WELL NO. #1 Abrahamson

COMPANY Sterling Drlg.

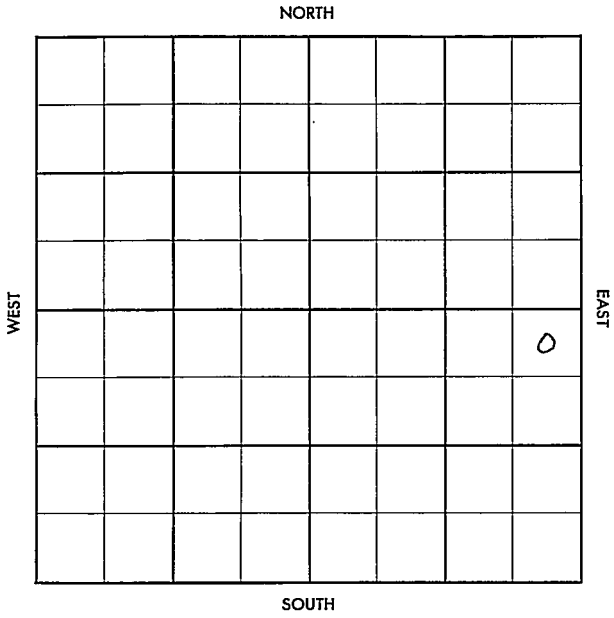

FORM 504-3 SUNRAY

Pawnee **KANSAS**

SEC.	TWP.	R.
34	22	18W

WELL NO.

#1 Abrahamson FARM
COMPANY

Sterling Drlg.
CONTRACTOR

Co. Tools

W.Garfield


_____ Ft. from N. Line

_____ Ft. from S. Line

_____ Ft. from E. Line

_____ Ft. from W. Line

NE NE SE

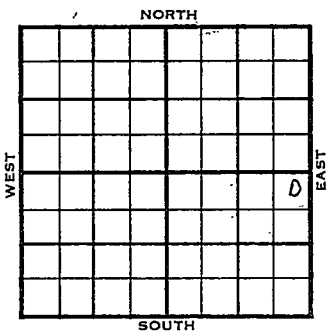

1955	ELEVATION ##### 2112' REPORT
12-14	MIR
1956	
1-5	Comm. 12-15-55 8 5/8" @ 320/125 DST 4271-93 op ½ hr. rec. 12' drlg. mud 180/20" D & A

H.	3704	3704
BL.	3800	3802
L.	3811	3812
Shly.		4273
Cg. Chert		4303
Sdy Cg.		4356
Miss.		4380
S.		4603
S.		4675

TD 4724'

ABANDONED

DX-78

FORM 513 REV. SUNRAY


Sec. 34 Twp. 22 Rge. 18W

Company Sterling Drlg.

Farm Name Abrahamson No. 1

TOPS	DEPTH	LOG	DATUM
Anh.			
T.P.			
H.			
Tr.			
Dg.			
B.L.			
L.			
K.C.			
B.K.C.			
Ce.			
C.			
M.			
M.			
K.			
Mr.			
Mo.			
V.			
S.			
S.			
A			
R.			
P€.			
G.			
T.D.			

Loc. in Sec. NE NE SE

Geol.

Contr. Co. tools

Pool W. Garfield

FIRST REPORT

DEC 14 '55

Date Comm. M I R

Co. Lse. No. Sec. T. R.

FORM 513 REV. SUNRAY

County Pawnee Elev. 2112

Sec. 34 Twp. 22 Rge. 18W

Company Sterling Drlg.

Farm Name Abrahamson No. 1


TOPS	DEPTH	LOG	DATUM
Anh.			
Tp.			
H.	3704	3704	1592
Tr.			
Dg.			
Bl.	3800	3802	1690
L.	3811	3812	1700
K.C.			
B.K.C.			
Ce.			
C. Stalnaker		4273	2161
M. Cantrell		4303	2191
M. Miller		4356	2244
K. Kinderhook		4380	2268
Mz.			
Mo.			
V.			
S.		4603	2491
S.			
A		4675	2563
R.			
P€.			
G.			
T.D.	4724		

Loc. in Sec. NE NE SE

Geol.

Contr. Co. tools

Pool W. Garfield

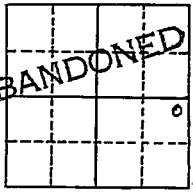

Date Comm. 12-15-55 JAN 5 1956

8 5/8" @ 320/125 DST 4271-93 open ½ hr.

rec. 12' drlg. mud 180/20"

D & A

Co. Lse. No. Sec. T. R.