

DRILLING WELL COMPLETION REPORT

Well No. 1 Farm Name H. A. Bowman
Date completed May 6, 1946
Description SE $\frac{1}{4}$ Section 34-22N-16W
County Pawnee, State Kansas
Initial production Test hole bbls. Total depth 1863 feet
Initial volume _____ cu. ft. _____ lbs. rock pressure

Pipe Line Company _____

Gas Company _____

Remarks: Surface casing parted. Test hole.

Skidded derrick to new location.

Al Davis

- 4
✓ Accounting Dept.
Scouting Dept.
Geological Dept.
Pipe Line Dept.
Inventory Comptroller
Rental Dept.
Legal Dept.
Tax Dept.
Engineering Dept.
Lease Inventory
File

DRILLING WELL COMPLETION REPORT

Well No. 1 A Farm Name H. A. Bowman

Date completed June 8, 1946

Description SE 1/4 Section 34-22S-16W

County Pawnee, State Kansas

Initial production _____ bbls. Total depth 4090 feet

Initial volume 5,500,000 cu. ft. 1400 lbs. rock pressure

Pipe Line Company _____

Gas Company _____

Remarks: _____

A. E. PIERCE

☒ Accounting Dept.
☐ Scouting Dept.
☒ Geological Dept.
☐ Pipe Line Dept.
☐ Inventory Comptroller
☐ Rental Dept.
☐ Legal Dept.
☐ Tax Dept.
☐ Engineering Dept.
☐ Lease Inventory
☐ File
Mr. F. B. Koontz

MID-CONTINENT PETROLEUM CORPORATION

H. A. Bowman Well #1-A
 Sec. 34-22-16W, Pawnee County, Kansas
 Commenced: 5-8-46
 Completed: 6-8-46
 Initial Production: 3 1/2 Million cubic feet gas
 1400 lb. rock pressure

Casing: 8 5/8" 980.61'
 5 1/2" 4082.50'

FORMATION	TOP	BOTTOM
Sand and clay	0	240
Shale and shells	240	460
Sand	460	550
Red bed	550	728
Red bed and shale	728	985
Lime - Anhydrite	985	1020
Shale and shales	1020	1100
Red bed	1100	1450
Shale and shells	1450	1500
Shale, salt and sand	1500	1800
Broken lime	1800	1860
Lime and shale	1860	2075
Sandy lime	2075	2255
Lime and shale	2255	2325
Broken lime	2325	2390
Lime and shale	2390	2600
Shale and shells	2600	2660
Shale lime and shells	2660	2750
Shale and lime	2750	2815
Shale and shells	2815	2975
Shale and lime	2975	3030
Shale and shells	3030	3305
Lime	3305	3500
Shale and lime	3500	3610
Lime	3610	3910
Lime and shale	3910	3965
Broken lime, shale, red bed, chert	3965	3984
Shale and lime	3984	4015
Cherty conglomerate	4015	4030
Chert and sand	4030	4042
Chert and sand	4042	4050
Sand, chert, lime	4050	4067
Lime (Arbuckle)	4067	4090
		Top of Lansing lime
		Top of Simpson sand
		Top of Arbuckle lime
		T. D.

Perforated:


1 shot from 4042
 10 " " 4042 to 4046
 12 " " 4032 to 4036

LOCATION NOTICE

TULSA, OKLA., April 23, 1946

WELL NO. 1 ON H. A. Bowman FARM

WILL BE AS FOLLOWS:

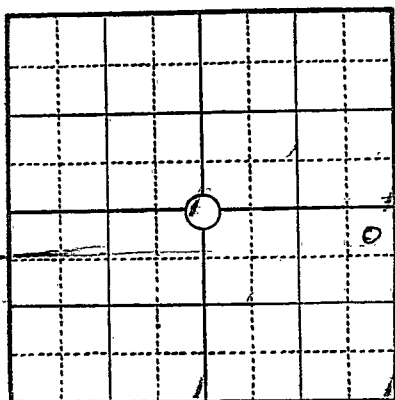

330 FEET FROM NORTH LINE
530 FEET FROM EAST LINE
 FEET FROM SOUTH LINE
 FEET FROM WEST LINE

IN SE 1 SEC. 34 TWP. 22S RANGE 16W
Pawnee COUNTY, STATE OF Kansas

REMARKS: Lloyd Snyder, District Supt.
A. E. Johnson, District Foreman

SIGNED _____

Al Davis

COPIES TO

- DISTRICT SUPT.
- ACCOUNTING DEPT.
- RENTAL DEPT.
- SCOUTING DEPT.
- ENGINEERING DEPT.
- LEGAL DEPT.
- LEASE INVENTORY
- CLAIM DEPT.
- TAX DEPT.
- GEOLOGICAL DEPT.
- PURCHASING DEPT.
- PIPE LINE DEPT.
- PRIORITIES DEPT.
- FILE

Wade
Mike Small


J. H. Se

Twin Lost H

LOCATION NOTICE

TULSA, OKLA., May 6, 1945WELL NO. 1-A ON H. A. Bowman FARM

WILL BE AS FOLLOWS:

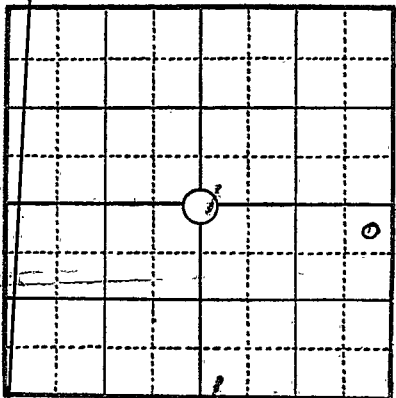351 FEET FROM NORTH LINE394 FEET FROM EAST LINE

FEET FROM SOUTH LINE

FEET FROM WEST LINE

IN SE4 SEC. 34 TWP. 22S RANGE 16WPawnee COUNTY, STATE OF KansasREMARKS: Lloyd Snyder, District Supt.A. E. Johnson, District Foreman.

SIGNED _____

COPIES TO

DISTRICT SUPT.
 ACCOUNTING DEPT.
 RENTAL DEPT.
 SCOUTING DEPT.
 ENGINEERING DEPT.
 LEGAL DEPT.
 LEASE INVENTORY
 CLAIM DEPT.
 TAX DEPT.
 GEOLOGICAL DEPT.
 PURCHASING DEPT.
 PIPE LINE DEPT.
 PRIORITIES DEPT.
 FILE

LEASE SOLD

REPORT OF PRODUCING ~~WELL IN A BARRON~~Well No. 1A Farm Name H. A. BowmanDescription SE 1/4 Sec. 34-223-16WCounty Rawson State KansasDate ~~Plugging Completed~~ SOLD: February 14, 1947Sold to J. H. Huber Corporation.

Accounting Dept.

Rental Dept.

Scouting Dept. ✓

Engineering Dept.

Legal Dept.

Lease Inventory Man

Tax Dept.

Purchasing Dept.

File

A. E. PIERCE