


Section 34 Township 22 Range 29-W

Well Number 1 Ely

Company Keefe & Olson Drlg.

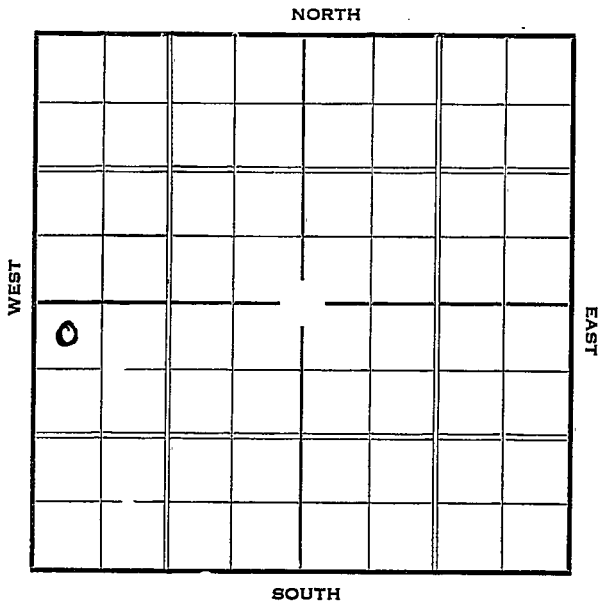

Special

KANSAS Finney

Sec. 34 Twp. 22 R. 29-W

Well No. #1 Ely Farm


Keefe & Olson Drlg. Company

330 Ft. from N. Line

_____ Ft. from S. Line

_____ Ft. from E. Line

330 Ft. from W. Line

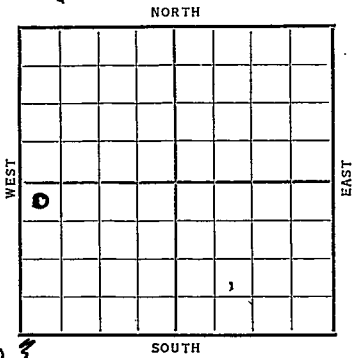

Special *Elev. 2703*

Date	REPORT
1937	
2/10	Rigging up.
2/18	Surface hole.
2/26	No Report
3/4	12" @ 260 Anhydrate 1345'
	Drlg. 2770'.
3/11	Drlg. 3553'
3/18	Lansing 3950'. Drlg. 4430'
3/25	Mississippi L. 4655'.
	Drlg. 4795'.
4/2	Drlg. 5197'.
4/8	Viola 5315' Drlg. 5502'
4/14	Simpson 5460'.
	Sil. 5470'.
	T.D. 5556'.
	ABANDONED

KANSAS

Map No. No Map Sec. 34 Twp. 22 R. 29W

Well No. 1 Ely

Keefe & Olson, Inc. Company

Contractor

Special

SECTION PLAT

330 Ft. from N. Line

_____ Ft. from S. Line

_____ Ft. from E. Line

330 Ft. from W. Line

FIRST REPORT

0			

Location _____

Rig up _____

Drilling and Remarks:

Rigging up

RECORD

Cased _____ in., _____ ft.

Sand _____

Gas _____

Oil _____

Total Depth _____

PRODUCTION

1st 24 hrs. Nat. _____

1st 24 hrs. after shot _____

Gas _____ Cu. Ft.

Dry Hole _____

Abandoned _____

Date

FEB 10 1937 19

S. J. LEWIS Scout

Map No. WM Sec. 34 Twp. 22 R. 29WWell No. 1 E 19Keefe & Olson Oil Co Company

Contractor

SECTION PLAT

0			

330 Ft. from N. Line

_____ Ft. from S. Line

_____ Ft. from E. Line

330 Ft. from W. Line

ABANDONED

Location _____

Rig up _____

Drilling and Remarks:

Simpson 5460S. C. 5470

RECORD

Cased _____ in., _____ ft.

Sand _____

Gas _____

Oil _____

Total Depth 5556

PRODUCTION

1st 24 hrs. Nat. _____

1st 24 hrs. after shot _____

Gas _____ Cu. Ft.

Dry Hole Abandoned

Date

APR 24 1937 19S. J. LEWIS Scout