


DX 78-1

Section 34 Township 22 Range 33W
Well No. 4 Finnup
Company W. L. Hartman

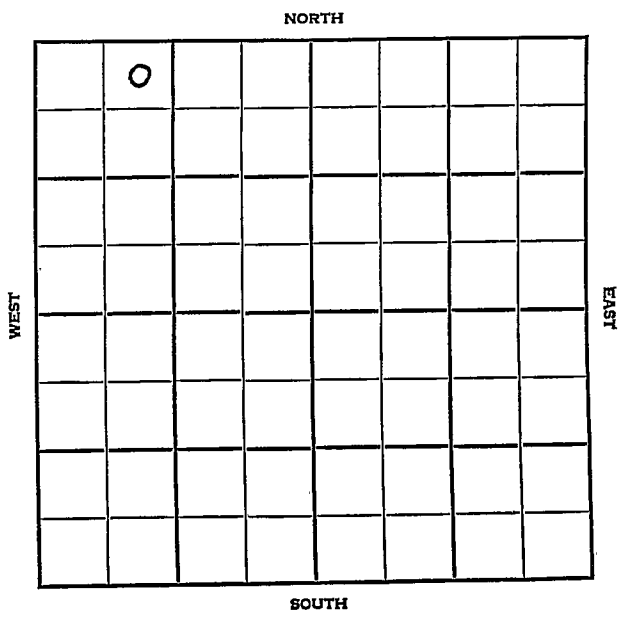

SEC.	TWP.	R.
34	22	33W

WELL NO.

4 Finnup

FARM

COMPANY

W. L. Hartman

CONTRACTOR

H & H Drkg


Damme Pool

330 Ft. from N. Line

Ft. from S. Line

Ft. from E. Line

990 Ft. from W. Line

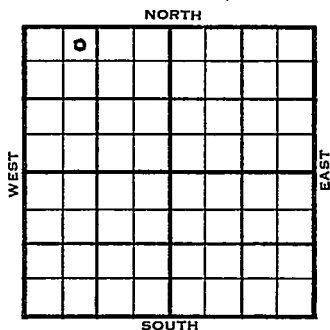

NE NW NW

	ELEVATION	REPORT
1954	2883	-

7/7 Spudding 7-2-54
8" @ 285
Drlg. 2315

7/21 Marm 4354', Cher. 4474'
Drlg. 4552'

8/18 Spud 7-2-54 Oil well TD 4798
8" @ 285 Heeb 3805 Marm 4354
Cherokee 4474 Miss 4698 TD 4798
5" @ 4796 24/4775-79 S/75 BO 12 hr.
Comp. 150 BOPD

COMPLETED

County Finney State Kansas
 Sec. 34 (Blk.) 22 (Sur.) 33W Map No.
 Operator W. L. Hartman
 Well No. 4 Farm Finney
 Elev. 2883 Location NE NW NW

o					

FIRST REPORT

330 Ft. From N Line NW
990 Ft. From W Line Quarter
 Ist. Report JUL 7 1954
 Completion _____
 Remarks _____
H & H Drlg. - Contr.
 Spudding Date 7-2-54

Drlg. Data

Damme Pool8" @ 285 drlg. 2315

J. G. McGEHEE

County Finney State Kansas
 Sec. 34 (Blk. 22 (Sur. 33W Map No.
 (Twp.) (Rge.)
 Operator W. L. Hartman
 Well No. 4 Farm Finnup
 Elev. 2883 Location NE NW NW

0						

330 Ft. From N Line NW
990 Ft. From W Line Quarter
 1st. Report
 Completion AUG 18 1954
 Remarks Damme Pool
H & H Drlg. - Contr.
 Spudding Date 7-2-54

Drlg. Data Oil well TD 4798
8" @ 285 Heeb. 3805 Marm. 4354
Cherokee 4474 Miss. 4698 TD 4798
5" @ 4796 24/ 4775-79 S/ 75 bo 12 hr.
Comp. 150 bopd

FABEN GILSTRAP