

Section 34 Township 22 Range 33 WWell No. # 2 FinnupCompany W. L. Hartman

NORTH

		o					

WEST

EAST

SOUTH

Finney

KANSAS

 Sec. 34 Twp. 22 R. 33W

 Well No. #2 Finnup Farm

W. L. Hartman

Company

Contractor

1100

Ft. from N. Line


Ft. from S. Line

990

Ft. from E. Line

Ft. from W. Line

C S L SW NE NW

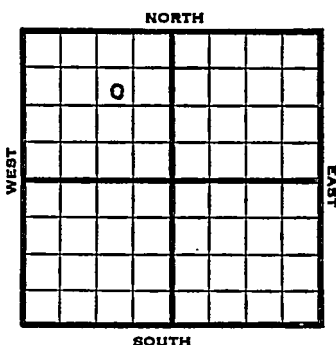

1953

Elev. 2878'

REPORT

7/22

Spud 7-19-53

13" @ 243'

Drlg.

7/29

Hol 2496

Her 2523

Kr 2545

Win 2581

B Win 2607'

Up Ft 2629

RTD 2655

7" @ 2655

8/5

N.R.

8/12

"

8/26

"

9/2

RUCT

9/9

CO

9/23

Spud 7-19-53

Gas Well

TD 2613'

13" @ 243'

Hol. 2496, Her. 2523, Kr 2545, Win 2581

7" @ 2613'

TD 2613'

CO to TD Perf 2596-2603 2000 A

78/ 2584-97 6000 A 96/ 2541-57

2000 A 96/ 2517-33 2000 A

28000 A

Comp. 4,762,000 gas 365#.

COMPLETED


County Finney State Kansas
 Sec. 34 (Blk.) 22 (Sur. Rge.) 33W Map No.
 Operator W. L. Hartman
 Well No. 2 Farm Finnup
 Elev. 2878 Location C S L SW NE NW

1100 Ft. From N Line NW990 Ft. From E Line Quarter1st. Report 101 2 1953Completion -Remarks Spudding Date 7-19-53

Drlg. Data

13" @ 243 drlg.

County Finney State Kansas
 Sec. 34 (Blk. 22 (Sur. 3 3W Map No.)
 Operator W. L. Hartman
 Well No. 2 Farm Finnup
 Elev. 2882 Location C S L SW NE NW

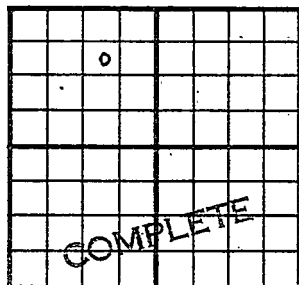

1100 Ft. From N Line NW
990 Ft. From E Line Quarter

1st. Report

Completion SEP 23 1953

Remarks

Spudding Date 7-19-53

Drilg. Data Gas well TD 2613
13" @ 243 Hol. 2496 Her. 2523
Kri. 2545 Win. 2581 7" @ 2613 TD 2613
Co to TD perf/ 2596-2603 2000 A
78/ 2584-97 6000 A 96/ 2541-57
2000 A 96/ 2517-33 2000 A 28000 A
Comp. 4,762,000 gas 365#