

DX 78-1


Finney

KANSAS

Section 34 Township 22 Range 33 W

Well No. # 3 Finnup

Company Hartman

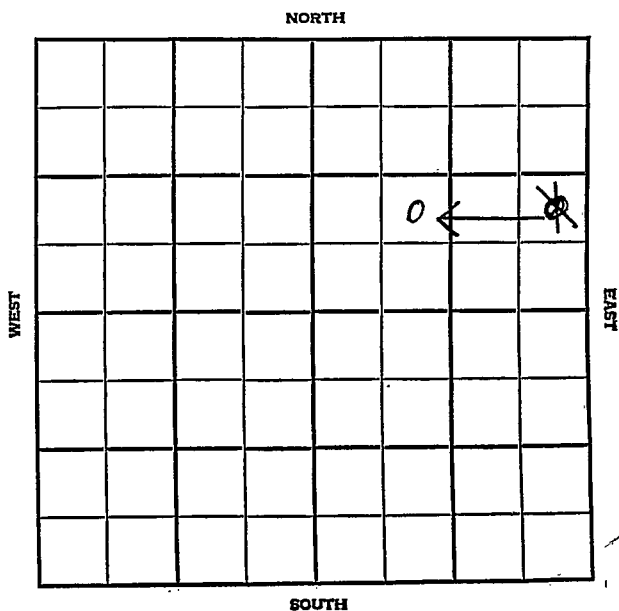

Finney KANSAS

SEC.	TWP.	R.
34	22	33W

WELL NO. 3 Finnup FARM

COMPANY Hartman


CONTRACTOR H & H Drlg.

_____ Ft. from N. Line

990 _____ Ft. from S. Line

~~330~~ _____ Ft. from E. Line

990 _____ Ft. from W. Line

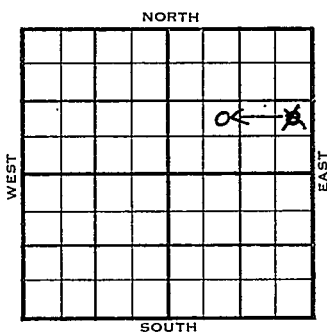

SW
NE SE NE

NE SE NE	ELEVATION	REPORT
1954	2872'	

7/28	Location
11/3	Spud 7-28-54
	Oil Well
	TD 4816'
	8" @ 245'
	Heeb 3796', Lans 3837', B KC 4315',
	M arm. 4346', Cherokee 4455', Miss
	4668'
	TD 4816'
	5" @ 4816'
	CO
	Perf 4767-70, S/72 bop 12 hrs.
	C omp. 150 bopd

COMPLETED

Kansas

Map No. _____ Sec. 34 Twp. 22 R. 33WWell No. 3 Finnup

Hartman

CORRECTION

Company

Contractor

NE SW NE

SECTION PLAT

		0	

Ft. from N. Line

990 Ft. from S. Line

Ft. from E. Line

990 Ft. from W. Line

Finney County

Location _____

Rig up _____

Drilling and Remarks:

Reported
NE SE NE

RECORD

Cased _____ in., _____ ft.

Sand _____

Gas _____

Oil _____

Total Depth _____

PRODUCTION

1st 24 hrs. Nat. _____

1st 24 hrs. after shot _____

Gas _____ Cu. Ft.

Dry Hole _____

Abandoned _____

Date

AUG 4 1954₁₉

J. G. McGEHEE

Scout

County Finney State Kansas

Sec. 34 (Blk. Twp.) 22 (Sur. Rge.) 3 SW Map No.

Operator Hartman

Well No. 3 Farm Finnup

Elev.	2872	Location	NE SW NE
-------	------	----------	----------

0

COMPLETE

990 Ft. From S Line NE 6

990	Ft. From	TAT	Line	Quarter
-----	----------	-----	------	---------

1st. Report _____

Completion NOV 3 1954

Remarks

H & H Drlg. - Contr.

Spudding Date 7-28-54

Drig. Data Oil well TD 4816

8" @ 245 Heeb. 3796 Lans. 3837

B KC 4315 Marm. 4346 Cherokee 4455

Miss. 4668 TD 4816 5" @ 4816

C0 perf/4767-70 S/ 72 bo 12 hr.

Comp. 150 bond

FABEN GILSTRAP