

Section 34 Township 22 Range 33 WWell No. # 1 G. W. FinnupCompany W. L. Hartman

NORTH

			0				

WEST

EAST


SOUTH

Finney

KANSAS

Sec. 34 Twp. 22 R. 33WWell No. #1 G.W. Finnup FarmW.L. Hartman CompanyWildcat. Deep Test. Contractor330 Ft. from N. Line Ft. from S. Line330 Ft. from E. Line Ft. from W. Line

NE NE NW

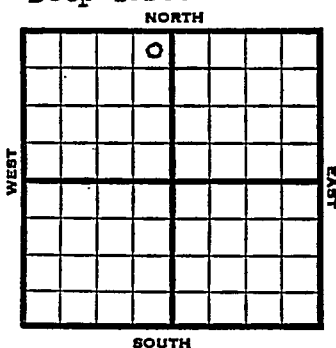

1953 Elev. 2884' REPORT

6/24 Spud 6-15-53
10" @ 235'7/1 Hol 2498 Her 2524' Kr 2546
Win 2582 B Win 2610 Up Ft 2630
Heeb 2810 Lans 2850
Drlg. 3875'7/8 Marm 4342' Cherokee 4482'
Drlg. 4500'7/22 Patterson sd 4681, G ong 4740, Miss
4752,
DST 4752-83, 3/4 hrs., 2700' gas,
1620' clean oil, 180' mco, 1150#
DST 4833-41,
DST 4784-4833, 1 hr., 80' m + SS, 1020#
DST 4833-41, 3/4 hrs., 15' M
RTD 4905
5" @ 4905

OVER

J. G. McGEHEE

County Finney State Kansas
 Sec. 34 (Blk. 22 (Sur. 33W Map No.
 (Twp.) (Rge.)
 Operator W. L. Hartman
 Well No. 1 Farm G. W. Finnup
 Elev. 2884 Location NE NE NW

		6			

330 Ft. From N Line NW330 Ft. From E Line Quarter

1st. Report

Completion AUG 26 1953Remarks WildcatSpudding Date 6-15-53Drilg. Data Oil well TD 490510" @ 235 Hol. 2498 Her. 2524Kri. 2546 Win. 2582 B Win. 2610Ft. Riley 2630 Heeb. 3810 Lans. 3850Marm. 4342 Cherokee 4482 Patterson sd4681 Cong. 4740 Miss. 4752DST 4752-83 open 3/4 hr. Rec. 2700' gas1620' clean oil 180' mco 1150#DST 4833-41 DST 4387-4410 open 40 min.Rec. 30' mud 850# DST 4480-4505open 3/4 hr. Rec. 40' mud 900#DST 4784-4833 open 1 hr. Rec. 80' mud& SSO 1020# DST 4833-41 open 3/4 hr.Rec. 15' mud TD 4905 5" @ 4905Perf/ 4756-62 S/ 72 bo 12 hr.Comp. 434 bopd

J. G. McGEHEE

1953

8/26

Spud 6-15-53

Oil Well

TD 4905

10" @ 235

Hol 2498, Her 2524, Kri 2546, Win
2582, B. Win 2610, Ft. Riley 2630,
Heeb 3810, Lans 3850, Marm 4342,
Cherokee 4482, Patterson sd 4681,
Cong 4740, Miss 4752

DST 4752-83, opn 3/4 hrs., rec. 2700'
gas, 1620' clean oil, 180' mco,
1150#

DST 4833-41,

DST 4387-4410, opn 40", rec. 30' mud
850#

DST 4480-4505, opn 3/4 hrs., rec.
40' mud, 900#

DST 4784-4833, opn 1 hr., rec. 80'
mud, & SSO, 1020#

DST 4833-41, opn 3/4 hrs., rec. 15'
mud,

TD 4905

5" @ 4905

Perf 4756062, S/72 bo 12 hrs.

Comp. 434 bopd

COMPLETED