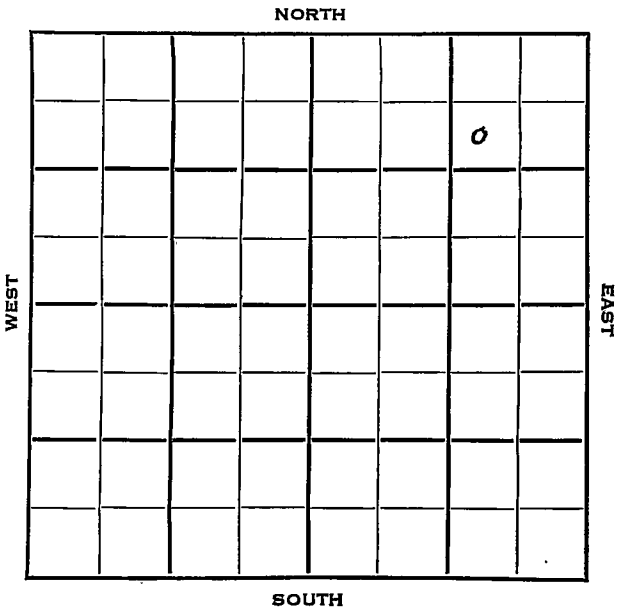


Section 34 Township 2 2 Range 33WWell No. #2 RolfCompany Champlin Ref.

Finney KANSAS

SEC.	TWP.	R.
34	22	33W ✓

WELL NO.

2 Rolf

FARM

COMPANY

Champlin Refg.

CONTRACTOR

Champlin


Finnup Pool

990 Ft. from N. Line

Ft. from S. Line

990 Ft. from E. Line

Ft. from W. Line

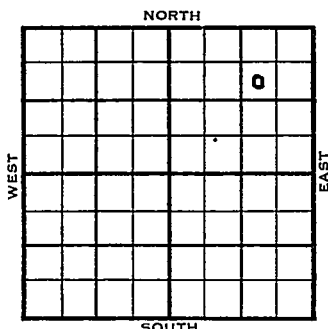

SW NE NE

1954	ELEVATION	REPORT
	2877'	

2/17	Spud 2-11-54 10" @ 357' Drlg. 2383'	Miss Test
2/24	Fish @ 2994'	
3/10	Heeb 3800', Lans 3841' Drlg 4291'	
3/17	B KC 4318' Marm 4344', Cher 4459' Miss 4678', St. Louis 4752' DST 4754'-71' 1 hr, 1020' gas 480' Hly O&GCM, 730# RTD 4811 Csg. 7" @ 4810'	
3/24	66/ 4756-67 S/ 2 boph 12hrs.	
4/21	Spud 2-11-54 Oil well TD 4811 10" @ 357' Heeb 3800' Lans. 3841' B KC 4318' Marm. 4344' Cherokee 4459' Miss. 4678' St. Louis 4752' DST 4754-71 open 1 hr rec 1020' gas, 480' HO & GCM 730# TD 4811 7" @ 4810' 66/4756-67 S/2 BOPH 12 hr. Comp. 59 BOPD	

COMPLETED

County Finn State Kansas

Sec. **34** (Blk. **22** (Sur. **337** Map No.

Operator Champlin Ref.

Well No. **2** Farm **Rolf**

Elev.	Location	SW	NE	NE
-------	----------	----	----	----

FIRST REPORT

990 Ft. From N Line NE

990 Ft. From ~~7~~ Line Quarter

1st. Report. FEB 17 1954

Completion

Remarks Miss test


Champlin - Contr.

Spudding Date **2-11-54**

Drig. Data Pinnup Pool

10" @ 357 drlg. 2383

County Finney State Kansas
 Sec. 34 (Blk. 22 (Sur. 33W Map No.)
 Operator Champlin Ref.
 Well No. 2 Farm Rolf
 Elev. 2877 Location SW NE NE

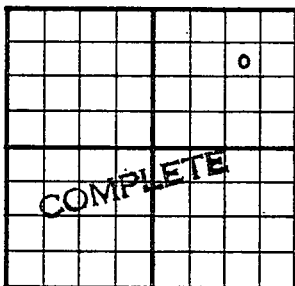

990 Ft. From N Line NE
 990 Ft. From E Line Quarter
 Ist. Report
 Completion APR 21 1954
 Remarks Finnup Pool
Champlin - Contr.
 Spudding Date 2-11-54

Drlg. Data Oil well TD 4811
10" @ 357 Heeb. 3800 Lans. 3841
B KC 4318 Marm. 4344 Cherokee 4459
Miss. 4678 St. Louis 4752 DST 4754-71
open 1 hr. Rec. 1020' gas 480' ho & gcm
730# TD 4811 7" @ 4810 66/ 4756-67
S/ 2 boph 12 hr. Comp. 59 bopd

J. G. McGEHEE