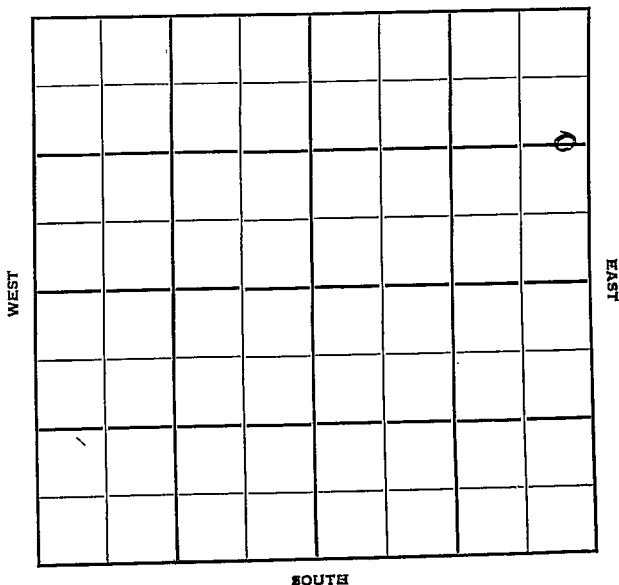


KANSAS

Kearny

Section 34 Township 22 Range 35WWell No. 1 JayCompany Warren Pet.Hugoton
NORTH

Kearny

KANSAS

Sec. 34 Twp. 22 R. 35W

Well No. #1 Jay Farm

Warren Pet.

Company


Hugoton Pool (Burris, Cont.) NORTH

1320' Ft. from N. Line

 Ft. from S. Line

150' Ft. from E. Line

 Ft. from W. Line

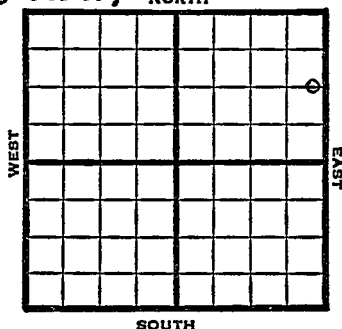

C E L NE

1949	Elev 3033'	REPORT
8/10	RUR	
8/17	10" @ 199'	
	Drlg. 2455'	
8/24	TD 2520-7" @ 2514'	
8/31	"	
9/7	"	
9/14	TD 2605'	
	4000 acid	
9/21	174' of 5" Perf liner @ 2670 TD	
9/28	TD 2670'	
	7" @ 2514'	
	174' of 5" Perf Liner @ 2670'	
	30000 acid	
	19,524,000 Gas	
	410# R Pr.	
	Comp	
	COMPLETED	

Kansas

Map No. _____ Sec. 34 Twp. 22 R. 35WWell No. 1 Jay

Warren Pet. _____ Company _____

Burris _____ Contractor _____


C E L N E

FIRST REPORT
SECTION PLAT1320 Ft. from N. Line

_____ Ft. from S. Line

150 Ft. from E. Line

_____ Ft. from W. Line

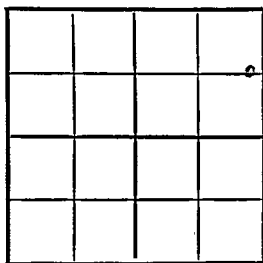

Kearny County

RECORD

Location _____

Cased _____ in., _____ ft.

Rig up _____

Sand _____

Drilling and Remarks:

Gas _____

R U R

Oil _____

Total Depth _____

PRODUCTION

1st 24 hrs. Nat. _____

1st 24 hrs. after shot _____

Gas _____ Cu. Ft.

Dry Hole _____

Abandoned _____

Date

AUG 10 1949

19

S. J. LEWIS

Scout

Map No. _____ Sec. 34 Twp. 22 R. 35W

Well No. 1 Jay

Warren Pet.

Company

COMPLETE

Contractor

C E L NE


E1323
SECTION PLAT

1320 Ft. from N. Line

_____ Ft. from S. Line

150 Ft. from E. Line

_____ Ft. from W. Line

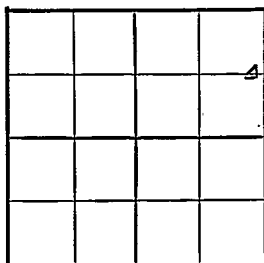

Kearny County

RECORD

Location _____

Cased _____ in., _____ ft.

Rig up _____

Sand _____

Drilling and Remarks:

Gas _____

7" C 2514

Oil _____

174' x 15" Prof. 1/2 in. 1/2

Total Depth 2670

C 2670

PRODUCTION

200000 cu. ft.

1st 24 hrs. Nat. _____

19,527,000 gal.

1st 24 hrs. after shot _____

Gas _____ Cu. Ft.

Dry Hole _____

410 R 1/2*

Abandoned _____

Date

SEP 28 1949 19

S. J. LEWIS Scout