


Section 35 Township 22 Range 12 W

Well No. #1 Rogers

Company Thunderbird Drlg. In.c

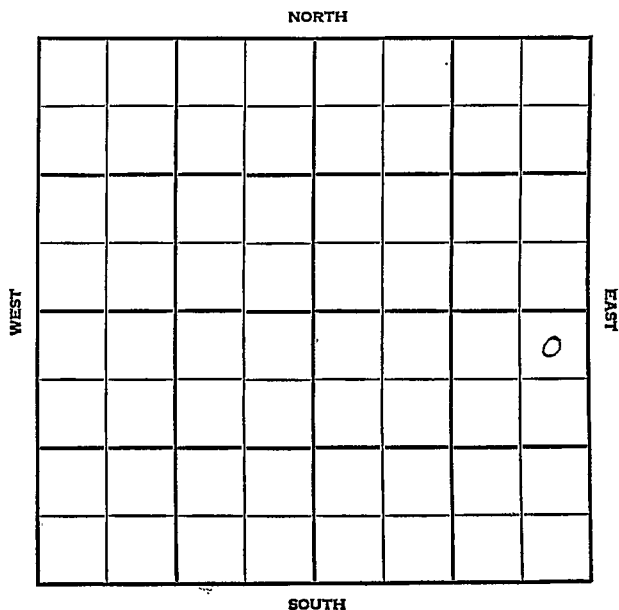

Stafford

KANSAS

SEC.	TWP.	R.
35	22	12W

WELL NO. I Rogers FARM

COMPANY Thunderbird Drlg Inc.

CONTRACTOR Co. Tools


Wildcat

\_\_\_\_\_ Ft. from N. Line

\_\_\_\_\_ Ft. from S. Line

\_\_\_\_\_ Ft. from E. Line

\_\_\_\_\_ Ft. from W. Line

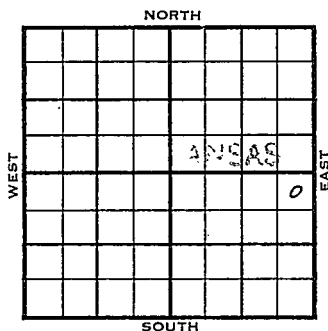

NE N<sup>E</sup> SE

1955	ELEVATION 1828 KB	REPORT
------	----------------------	--------

8/17 M I R

9-21 Comm. 8-16-55  
 8 5/8" @ 2101 w/175  
 DST 3281-3305 op 30" rec. 10' mud, BHPO#  
 DST 3321-48 open 1 hr. rec 60' mud  
 specks of oil BHP 430#  
 DST 3448-66 open 75" rec. 120' mdy wtr.  
 BHP 1110# FP 30-60  
 DST 3613-18 op 45" rec. 30' so&gem  
 BHP 380#  
 DST 3615-34 op 90" 285' gas 10' o&gem  
 plus 60' vho&gem plug 60' mdy gassy ~~KB~~  
 oil BHP 830# 20"  
 DST 3633-68 op 1 hr. 200' gas 50' mdy  
 gsy oil, plug 55' vho&gemw BHP 880  
 5 1/2" 3705 16/3627-31 no tst nat 75p  
 mud acid  
 Swb 5 1/2" bwph no oil  
 D & A  
 TOPS: ~~4~~h: 560  
 H: 3100'  
 B.L. 3236-3237  
 L. 3260-3261  
 B.K.C. 3514  
 C. 3538  
 S. 3576-3577  
 A 3612-3611  
 T.D. 3705'

ABANDONED

County Stafford Elev. \_\_\_\_\_  
 Sec. 35 Twp. 27 Rge. 12W  
 Company Thunderbird Drilg. Inc.  
 FarmName Rogers No. 7

TOPS	DEPTH	LOG	DATUM	Loc. in Sec.									
Anh.				NE NE SE									
Ip.													
H.													
Tr.													
Dg.													
Bl.													
L.				Geol. _____									
K.C.				Contr. _____									
B.K.C.				Co. tools _____									
Ce.				Pool _____									
C.				Wildcat _____									
M.				<table border="1"> <tr> <td></td> <td></td> <td></td> </tr> <tr> <td></td> <td>AUG 17 '55</td> <td></td> </tr> <tr> <td></td> <td></td> <td></td> </tr> </table>					AUG 17 '55				
	AUG 17 '55												
M.													
K.													
Mz.													
Mq.													
V.													
S.													
S.													
A.													
R.													
PE.													
G.													
T.D.													

Date Comm. M I R

13

Co.

Lse.

No.

Sec.

T.

R.

County Stafford Elev. 1828 KB  
 Sec. 35 Twp. 22 Rge. 12W  
 Company Thunderbird Drlg., Inc.  
 Farm Name Rogers No. 1

TOPS	DEPTH	LOG	DATUM	Loc. in Sec.
Anh.	560			NE NE SE
Tp.				
H.	3100		1272	
Tr.				
Dg.				
Bl.	3236	3237	1409	
L.	3260	3261	1433	Geol. <u>Foley</u>
K.C.				Contr.
B.K.C.		3514	1686	
Ce.				
C.		3538	1710	
M.				
M.				Pool
K.				<u>Pleasure Grove</u>
Mz.				<u>South</u>
Me.				
V.				
S.	3576	3577	1752	
S.				
A	3612	3611	1783	
R.				
PE.				ABANDONED
G.				
T.D.	3705	3705		

Date Comm. 8/16/55 SEP 21 1955

8 5/8" 2101 w/175 DST 3281-3305 open 30"

Rec. 10' mud BHP 0# DST 3321-48 open 1

hr. Rec. 60' mud specks of oil BHP 430#

DST 3448-66 open 75" Rec. 120' mdy wtr. BHP

1110# FP 30-60 DST 3613-18 open 45" Rec.

30' so& gcm BHP 380# DST 3615-34 open 90"

285' gas 10' o & gcm plus 60' vho & gcm

plug 60' mdy gassy oil BHP 830# 20" DST

3633-68 open 1 hr 200' gas 50' mdy gsy oil

SEP 29 1955

Scout Cards .. <i>Dg</i> .....
Land Small Map .....
Land Wall Map .....
Tracings .....
France Map .....
Pierce Map .....
Misc. ....

plug 55' who & gemw BHP 880 5<sup>2</sup>/<sub>7</sub>" 3705  
16/3627-31 no tst nat 750 mud acid  
Swb 5<sup>2</sup>/<sub>7</sub> bwph no oil  
D & A