


Section 35 Township 22 S Range 12 W

Well No. #1 Rogers

Company E. H. Adair

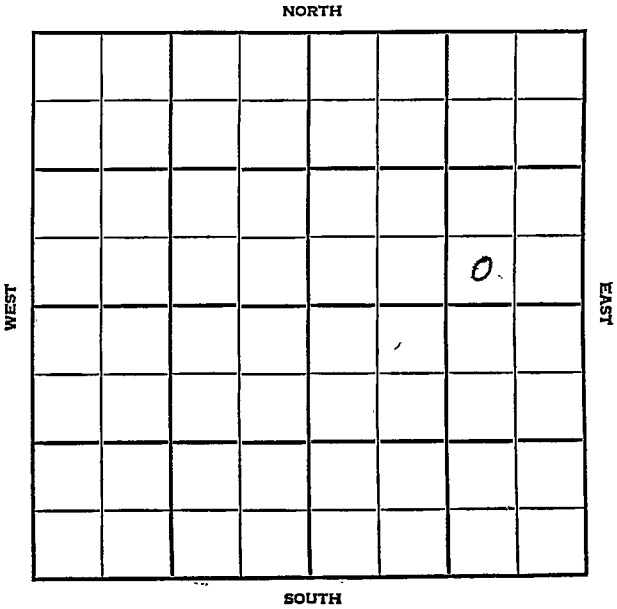



County Stafford Elev. \_\_\_\_\_  
 Sec. 35 Twp. 22S Rge. 12W  
 Company E. H. Adair  
 Farm Name Rogers No. 1

TOPS	DEPTH	LOG	DATUM
Anh.			
Tp.			
H.			
Tr.			
Dg.			
Bl.			
L.			
K.C.			
B.K.C.			
Ce.			
C.			
M.			
M.			
K.			
Mz.			
Me.			
V.			
S.			
S.			
A.			
R.			
PE.			
G.			
T.D.			

Loc. in Sec. SW SE NE  
 Geol. \_\_\_\_\_  
 Contr. Ben Brack  
 Pool Pleasant Grove  
So.


FIRST REPORT

Date Comm. 9-19-55 SEP 21 1955  
8" 233 w/250 s.s.; D 1200

*[Handwritten signature]*

Co.  
Lse.  
No.  
Sec.  
T.  
R.

County Stafford Elev. 1825  
 Sec. 35 Twp. 22 Rge. 12W  
 Company H. H. Adair  
 FarmName Rogers No. 1

TOPS	DEPTH	LOG	DATUM	Loc. in Sec.
Anh.				SW SE NE
Tr.				
Dg.	<u>31.35</u>		<u>1310</u>	
Bl.	<u>32.37</u>		<u>1412</u>	
L.	<u>32.63</u>		<u>1438</u>	Geol.
K.C.				Contr.
B.K.C.				
Ce.				
C.	<u>35.39</u>		<u>1714</u>	Ben Brack
M.				Pool
M.				S. Pleasant
K.				Grove
Mz.				
Me.				
V.				
S.	<u>35.97</u>		<u>1772</u>	
S.				
A.	<u>36.21</u>		<u>1796</u>	
R.				
PE.				
G.				
T.B.	<u>36.40</u>			

Date Comm. 9-19-55 OCT 5 1955

8" @ 233/250

D & A

Co.  
No.  
Sec.  
T.  
R.