



SEC.	TWP.	R.
35	22	15W

WELL NO. #1 Lovett FARM

COMPANY Rine Drlg. et al


CONTRACTOR Co. Tools.

330 Ft. from N. Line

Ft. from S. Line

Ft. from E. Line

330 Ft. from W. Line

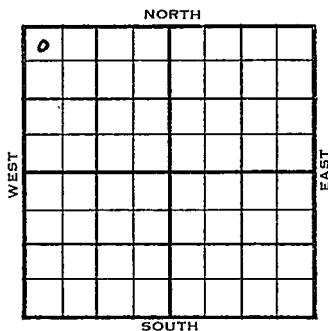

NW NW NW  
CSO - F/O

	ELEVATION	REPORT
1954	1988'	

10/13 Spud 10-10-54  
8" @ 390'

12/15 Drlg. 1045'  
Spud 10-10-54 Oil well TD 4041  
8" @ 390 Heeb 3410 Br line 3542  
Lans. 3551  
DST 3674-3700 open 1 hr rec 120' HOCM  
90' oil 1140#  
DST 3700-42 open 1/2 hr rec 15' mud Off  
B KC 3790 Cong. 3871 Viola 3907  
DST 3910-40 open 1 hr rec 15' SGCM  
52# Simp. 3976 Simp. sd. 3983  
Arb. 4031 TD 4041 5" @ 3829  
60 to 3700 46/3682-90 S/1 BOPH  
500 A S/40 BOPH 2 hr. P/10 BFPH  
11 hr. 92% wtr. declined to 30%  
P/45 BOPD 70% wtr.  
Comp. 54 BOPD 64% wtr.

**COMPLETED**

County Pawnee State Kansas

Sec. 35 (Blk. 22 (Sur. 15W (Twp. 22 (Rge. 15W Map No.

Operator Rine Drlg. etal.

Well No. 1 Farm. Lovett

Elev. \_\_\_\_\_ Location NW NW NW

o					

330 Ft. From N Line NW

330 Ft. From W Line Quarter

lst. Report OCT 13 1954

Completion \_\_\_\_\_

Remarks CSO - FO

Co. tools

Spudding Date 10-10-54

Drlg. Data \_\_\_\_\_

8" @ 390 drlg. 1045

FABEN GILSTRA

County Pawnee State Kansas  
 Sec. 35 (Blk. 22) (Sur. 15W) Map No. 15W  
 Operator Rine Drlg. etal.  
 Well No. 1 Farm Lovett  
 Elev. 1988 Location NW NW NW

0					

330 Ft. From N Line NW  
330 Ft. From W Line Quarter  
 Ist. Report \_\_\_\_\_  
 Completion DEC 15 1954  
 Remarks \_\_\_\_\_  
Co. tools  
 Spudding Date 10-10-54

Drlg. Data Oil well TD 4041  
8" @ 390 Heeb. 3410 Br. line 3542  
Lans. 3551 DST 3674-3700 open 1 hr.  
Rec. 120' hocm 90' oil 1140#  
DST 3700-42 open 1/2 hr. Rec. 15' mud  
0# B KC 3790 Cong. 3871 Viola 3907  
DST 3910-40 open 1 hr. Rec. 15' sgcm  
52# Simp. 3976 Simp. sd. 3983  
Arb. 4031 TD 4041 5" @ 3829  
CO to 3700 46/ 3682-90 S/ 1 boph  
500 A S/ 40 boph 2 hr. P/ 10 bfph  
11 hr. 92% wtr. declined to 30%  
P/ 45 bopd 70% wtr.  
Comp. 54 bopd 64% wtr.

FABEN GILSTRAP