

Harvey


Form 51-5M-2-29-34703

Map No. **KANSAS** Sec. 35 Twp. 22 R. 2<sup>w</sup>

Well No. 1- Lehman Farm

Mo Oil & Gas Company

NORTH

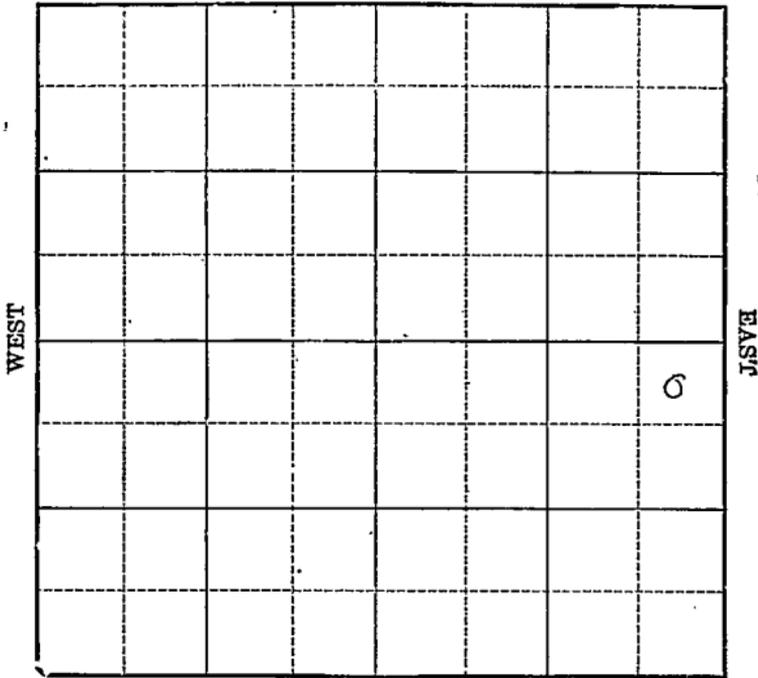

SOUTH

Location \_\_\_\_\_

Drilling Remarks \_\_\_\_\_

\_\_\_\_\_

\_\_\_\_\_

Rig Up \_\_\_\_\_

Drilling Remarks \_\_\_\_\_

\_\_\_\_\_

\_\_\_\_\_

**RECORD**

Cased \_\_\_\_\_ in. \_\_\_\_\_ ft.

Sand \_\_\_\_\_

Gas \_\_\_\_\_

Oil \_\_\_\_\_

Total Depth \_\_\_\_\_

**PRODUCTION**

1st 24 hrs. Nat. \_\_\_\_\_

1st 24 hrs. after shot \_\_\_\_\_

Gas \_\_\_\_\_ cu. ft.

Dry Hole \_\_\_\_\_

Abandoned \_\_\_\_\_

Map No. KANSAS Sec. 35 Twp. 22 R. 2<sup>w</sup>


Well No. 1- Lehman Farm  
Imo O & G Company

330 Ft. from N. Line

\_\_\_\_\_ Ft. from S. Line

330 Ft. from E. Line

1931 Ft. from W. Line

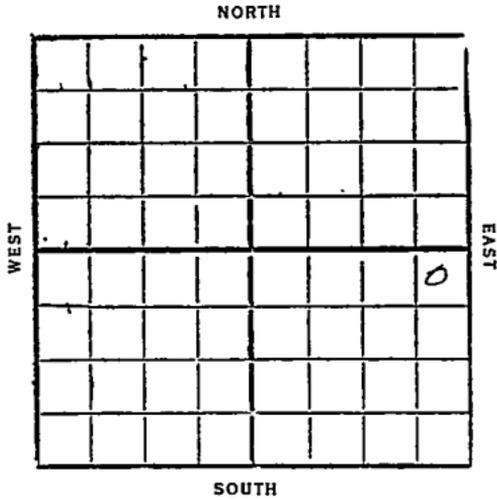

Date	REPORT
9/30	Cellar
10/17	Welding rig
10/14	Rig
10/21	Rig run up
10/28	drlg 450'
11/4	No report
11/10	10"-1030
11/18	Wrlg 1540'
11/24	10" collapsed at 2005' Fsg
12/2	—
12/19	—
12/16	TID 2270' Repairing boiler
12/22	8"-2006
12/30	Wrlg 2375'
1932	" 2625'
1/6	SD 2625'
1/13	6"-2708
	Wrlg 2917

1/20 - Top Chat 2957  
set 5" thru  
Est 3 to 5 #A gas  
from 2976+79 with  
65 bbls out oil 9 hrs

1/27 - T.D. 2979  
Correcting linkage

2/3 - T.D. 2979 No test

2/10 - —

2/17 - T.D. 2979  
swab 125 bbls oil  
and 50 " water  
in 24 hrs

2/26 - T.D. 2979  
Made 140 bbls oil  
and 70 " water  
in 12 hours

3/2 - Cased 5"-2957  
Chat 2957-83  
T.D. 2983  
flow 150 bbls oil  
and 150 " water  
in 12 hours  
Comp.

43

Harvey

Map No. KANSAS Sec. 35 Twp. 22 R. 2 W

Well No. 1 Lehman

Imo Oil & Gas Co Company

Contractor

FIRST REPORTS

SECTION PLAT

330 Ft. from N. Line

..... Ft. from S. Line

330 Ft. from E. Line

..... Ft. from W. Line

			o

Location .....

Rig up Cellar

Drilling and Remarks: .....

RECORD

Cased ..... in., ..... ft.

Sand .....

Gas .....

Oil .....

Total Depth .....

PRODUCTION

1st 24 hrs. Nat. ....

1st 24 hrs. after shot .....

Gas ..... Cu. Ft.

Dry Hole .....

Abandoned .....

Date

SEP 30 1931

CHAS. L. SHERWOOD

Harvey

43

Map No. KANSAS Sec. 35 Twp. 22 R. 2<sup>W</sup>

Well No. 1 Lehman

Imo Oil & Gas Co Company

Contractor

COMPLETE

SECTION PLAT

330 Ft. from N. Line

\_\_\_\_\_ Ft. from S. Line

330 Ft. from E. Line

\_\_\_\_\_ Ft. from W. Line

			0

Location \_\_\_\_\_

Rig up \_\_\_\_\_

Drilling and Remarks:

flow 150 lbs oil  
150 lbs water

12 Hours.

RECORD

Cased 5 in., 2957 ft.

Sand Chat 2957-2983

Gas \_\_\_\_\_

Oil \_\_\_\_\_

Total Depth 2983

PRODUCTION

1st 24 hrs. Nat. \_\_\_\_\_

1st 24 hrs. after shot \_\_\_\_\_

Gas \_\_\_\_\_ Cu. Ft.

Dry Hole \_\_\_\_\_

Abandoned \_\_\_\_\_

Date

MAR

2 1932

CHAS. L. SHERWOOD

Scout