


*Harvey*

Map No. KANSAS Sec. 35 Twp. 22 R. 2<sup>w</sup>

Well No. 1- Lehman Farm

Jones et al Company

NORTH

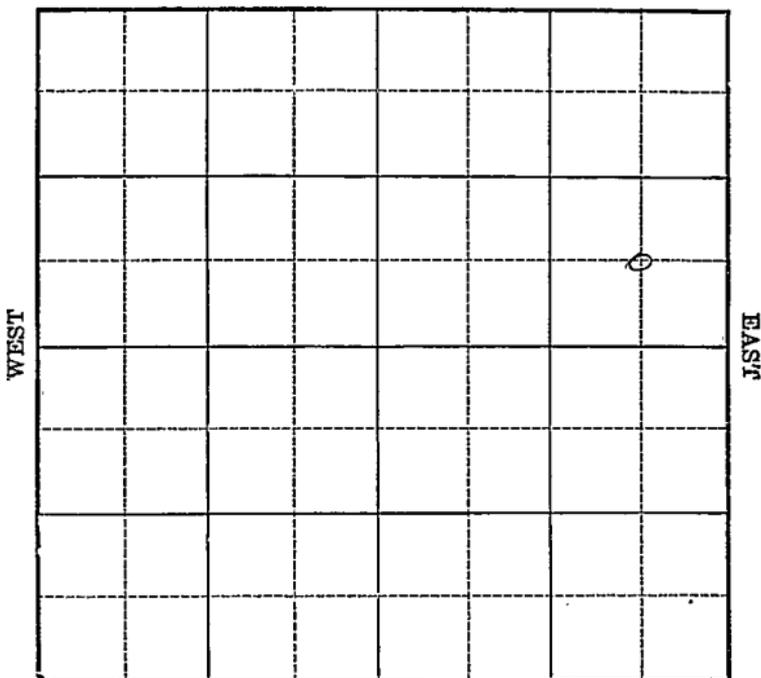

SOUTH

Location \_\_\_\_\_  
Drilling Remarks \_\_\_\_\_

Rig Up \_\_\_\_\_  
Drilling Remarks \_\_\_\_\_

\_\_\_\_\_  
\_\_\_\_\_  
**RECORD**

**PRODUCTION**

Cased \_\_\_\_\_ in. \_\_\_\_\_ ft.

1st 24 hrs. Nat. \_\_\_\_\_

Sand \_\_\_\_\_

1st 24 hrs. after shot \_\_\_\_\_

Gas \_\_\_\_\_

Gas \_\_\_\_\_ cu. ft. \_\_\_\_\_

Oil \_\_\_\_\_

Dry Hole \_\_\_\_\_

Total Depth \_\_\_\_\_

Abandoned \_\_\_\_\_

Map No. KANSAS Sec. 35 Twp. 22 R. 2<sup>w</sup>

Well No. 1- Lehman Farm

Jones et al Company


\_\_\_\_\_ Ft. from N. Line

660 Ft. from S. Line

660 Ft. from E. Line

\_\_\_\_\_ Ft. from W. Line

1930

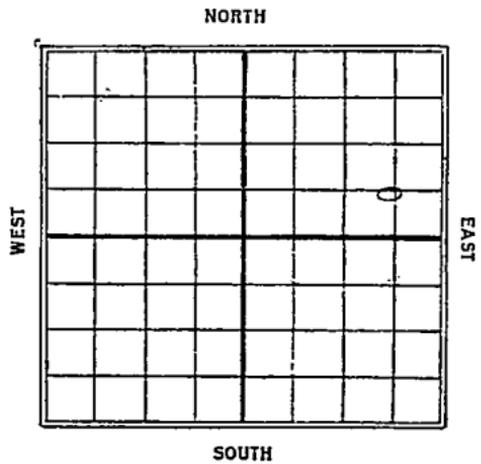

Date REPORT

Date	REPORT
9/24	Timbers
10/1	Rig
10/8	Run up
10/15	Dply 315'
10/22	" 1200'
10/29	" 1940'
11/5	" 2095" 10"-1975"
11/12	" 2485'
11/19	" 2610'
11/25	Run 6"-2768'
	2 7/8" 2680'
12/3	Top Chat 2965'
	5"-2967'
	3 1/2" A gas 2979'
	S.D. 2985' TD.
12/10	T.D. 2986'
	Mky 14 1/2" A gas
	and 300 bbls oil
	70% B.S. & water
12/17	T.D. 2986' shut in
	(over)

12/23- T.D. 2987  
flow 225 bbl 12 hrs  
mkg 40 bbl water an hr  
100# back pressure  
35° gravity

12/30- T.D. 2987 shut in

1981

1/17 —

1/14- Chat 2965-87  
T.D. 2987

flow 308 bbl oil &  
500 bbl water  
200# back pressure  
Comp.

*Harvey*

Map No. KANSAS Sec. 35 Twp. 22 R. 24

43

Well No. 1 Lehmann

Jones & Co Company  
Contractor

**SECTION PLAT**

\_\_\_\_\_ Ft. from N. Line

660 Ft. from S. Line

660 Ft. from E. Line

\_\_\_\_\_ Ft. from W. Line

			0

**FIRST REPOPTS**

Location \_\_\_\_\_

Rig up \_\_\_\_\_

Drilling and Remarks:

*Timbers*

**RECORD**

Cased \_\_\_\_\_ in., \_\_\_\_\_ ft.

Sand \_\_\_\_\_

Gas \_\_\_\_\_

Oil \_\_\_\_\_

Total Depth \_\_\_\_\_

**PRODUCTION**

1st 24 hrs. Nat. \_\_\_\_\_

1st 24 hrs. after shot \_\_\_\_\_

Gas \_\_\_\_\_ Cu. Ft.

Dry Hole \_\_\_\_\_

Abandoned \_\_\_\_\_

Date

SEP 24 1930


S. I. LEWIS Scout

*Harvey*  
 Map No. **KANSAS** Sec. *35* Twp. *22* R. *2W*  
*43*  
 Well No. *1 Lehmann*

*Jones & Co* Company  
 Contractor

SECTION PLAT

..... Ft. from N. Line  
*660* Ft. from S. Line  
*660* Ft. from E. Line  
 ..... Ft. from W. Line

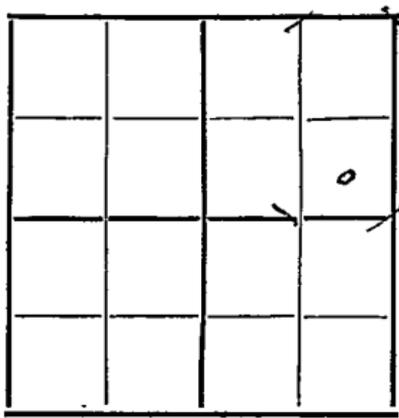

COMPLETED

Location.....

Rig up.....

Drilling and Remarks:

*Flooded 3088th  
 oil, 500 8th water  
 200 lbs pack pressure*

RECORD

Cased..... in., ..... ft.  
*2965 - 2987*  
 Gas *1/4*  
 Oil.....  
 Total Depth *2987*

PRODUCTION

1st 24 hrs. Nat.....  
 1st 24 hrs. after shot.....  
 Gas..... Cu. Ft.  
 Dry Hole.....  
 Abandoned.....

Date

**JAN 14 1931**  
 192.....

**S. J. LEWIS** Scout