


DX 78-1 Harvey

KANSAS

Section ~~32~~ 35 Township 22S Range ~~2E~~ 2W

Well No. #1 Ortman

Company W. Winnie, et al

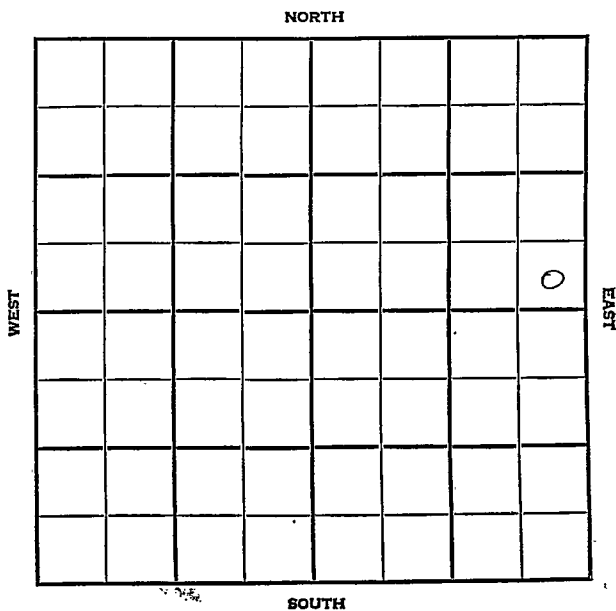

Harvey

KANSAS

SEC.

TWP.

R.

32 35

22

25 2W

WELL NO.

#1 Ortman

FARM

COMPANY

W. Winnie, etal

CONTRACTOR

Bedell & Catt

____ FT. FROM N. LINE


____ FT. FROM S. LINE

____ FT. FROM E. LINE

____ FT. FROM W. LINE

SE SE NE

NORTH

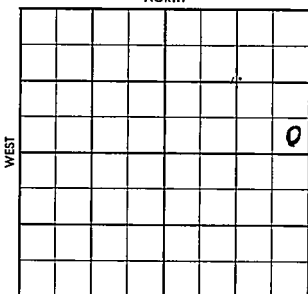

SOUTH

1956

ELEVATION

REPORT

7-25

Location

TOPS	DEPTH	LOG	DATUM	Loc. in Sec.
Anh.				SE SE NE
TP.				
H.				
Tr.				
Dg.				
BL.				
L.				Geol.
K.C.				
B.K.C.				Contr.
Ce.				Bedell & Catt
C.				
M.				Pool
M.				
K.				
Mz.				
Me.				
V.				
S.				
S.				
A.				
R.				
Pe.				
G.				
TP.				

JUL 25 1956

FIRST REPORT

No.

Date Comm. Loc.

6561 13JA

5

CORRECTION

FORM 513 SUNRAY

County Harvey

Elev. 1110

Sec. 36 35

Twp. 28S

Rge. 2E 2W

Company W. Winnie, et al

Farm Name Ortman

No. 1

TOPS	DEPTH	LOG	DATUM
Anb.			
Ip.			
H.			
Tr.			
Dg.			
Bl.			
L.	2347		
K.C.	2544		
B.K.C.	2733		
Ce.			
C.			
M.	2960		
M.			
K.			
Mz.			
Me.			
V.			
S.			
S.			
A.			
R.			
Pe.			
G.			
TD	2981		

Loc. in Sec. SE SE NE

Geol. Bedell & Catt

Contr. New zone

Pool 100

COMPLETE

OCT 10 1956

Date Comm. Loc. AUG 1 '56 7-29-56

8578 241/200 ID 1139

AUG 15 '56 4 1/2 2981

AUG 15 '56

CO

2981 Blew out EST 5 Mill

CF Rng Pkr. AUG 22 '56

AUG 29 '56

9a.

943 MCFG (wet) went to with

P13 2803 12/2665-68 (550)

to Acid SEP 5 '56 1/2 N.S. 1/2 1/2 FU

200 oil + 300 wtr POP SEP 12 '56

SEP 19 '56

SEP 26 '56

OCT 3 '56 P. 17 BO + 80 Bwpa