

Harvey


FORM 51 IOM 12-46 PETROL

KANSAS

Section 35 Township 22 Range 3W

Well No. 1 Eskom

Company Alpine Oil & Royalty

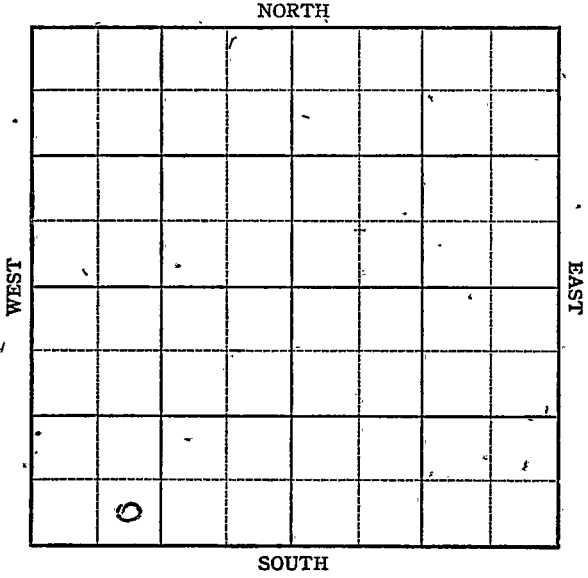

KANSAS

Harvey

Sec. 35 Twp. 22 R. 3-W

Well No. #1 Eskom Farm

Alpine Oil & Royalty Company

Halstead

Ft. from N. Line


330

Ft. from S. Line

Ft. from E. Line

990

Ft. from W. Line

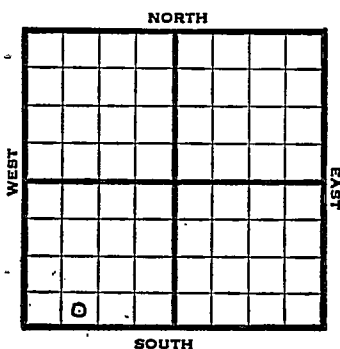

SE SW SW

1947 Elev. 1433' REPORT

6/11 Location

6/17 "

6/24 RUR

7/1 "

7/8 10" @ 824'  
WOC

7/16 Lansing 2470'  
Drlg. 2573'

7/22 Mississippi 3183  
5" @ 3267  
TD

7/28 " "

8/6 " "

8/13 " "

8/20 TD 3267'  
PB 3240'  
66 shots 3190-3240,  
2000 acid.

8/27 "

9/3 "

OVER

1947

9/10 TD 3267'  
PB 3240'

9/17 "

9/24 Flow 30 bbls. oil - 2 M Gas a day.

10/1 "

10/8 Miss. 3183'  
5" @ 3267'  
Perf.  
3,000 Acid  
Pump 25 oil Pot  
TD 3240'  
1½ M Gas  
TD 3240  
Gravity 38

**COMPLETED**

Map No. \_\_\_\_\_ Sec. 35 Typ. 22 R. 3W

Well No. 1 Eskom

Alpine Oil & Royalty Company

FIRST REPORT

Contractor

SE SW SW

SECTION PLAT


\_\_\_\_\_ Ft. from N. Line

330 \_\_\_\_\_ Ft. from S. Line

\_\_\_\_\_ Ft. from E. Line

990 \_\_\_\_\_ Ft. from W. Line

Harvey County

Location X

Rig up

Drilling and Remarks:

RECORD

Cased \_\_\_\_\_ in., \_\_\_\_\_ ft.

Sand \_\_\_\_\_

Gas \_\_\_\_\_

Oil \_\_\_\_\_

Total Depth \_\_\_\_\_

PRODUCTION

1st 24 hrs. Nat. \_\_\_\_\_

1st 24 hrs. after shot \_\_\_\_\_

Gas \_\_\_\_\_ Cu. Ft.

Dry Hole \_\_\_\_\_

Abandoned \_\_\_\_\_

Date

JUN 1 1 1947 19

S. J. LEWIS Scout

