


Section 35 Township 22 Range 16W

Well No. 1 Galliart

Company Champlin Ref.

Shady Creek Pool

NORTH

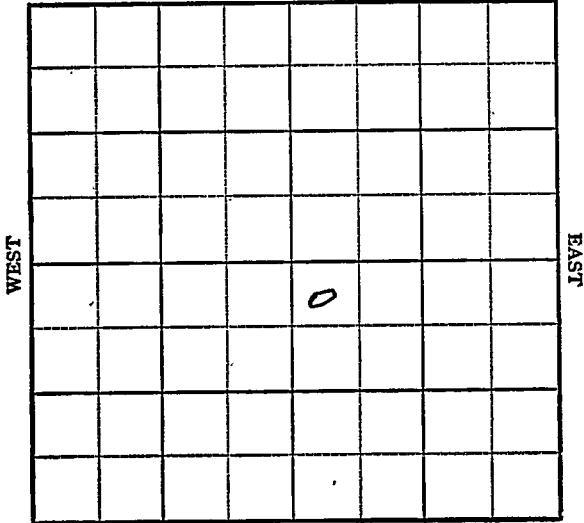

SOUTH

KANSAS

Pawnee

Sec. 35 Twp. 22 R. 16W ✓

Well No. #1 Calliart Farm

Champlin Ref.

Company

Shady Creek Pool


330' Ft. from N. Line

\_\_\_\_\_ Ft. from S. Line

\_\_\_\_\_ Ft. from E. Line

330' Ft. from W. Line

NW SE

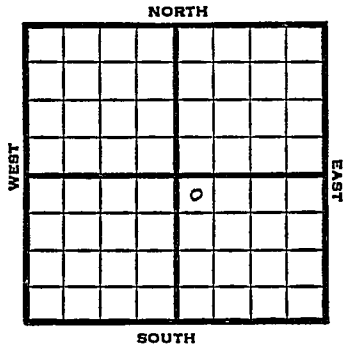

1948 Elev 2016' REPORT

12/29 Surface Hole

1/5 8" @ 981'  
Lansing 3602'  
Conglomerate 3949'  
Viola 3974'  
TD 3992'

1/12 Simpson 4006 Arbuckle 4037-78 TD  
Est 8 M Gas 5" @ 4078'

1/19 "

1/26 "

2/2 2500 acid

2/9 TD 4078'  
Arb. 4037'  
5" @ 4078'  
183 shots 4037-68  
2500 acid  
40 M Gas  
1136# R Pr.

Comp

**COMPLETED**

Map No. \_\_\_\_\_ Sec. 35 Twp. 22 R. 16W

Well No. 1 Galliar<sup>t</sup>

Champlin Ref. \_\_\_\_\_ Company \_\_\_\_\_

### FIRST REPORT

Contractor \_\_\_\_\_

NW SE

#### SECTION PLAT

330 Ft. from N. Line

\_\_\_\_\_ Ft. from S. Line

\_\_\_\_\_ Ft. from E. Line

330 Ft. from W. Line

		o	

Pawnee County

Location \_\_\_\_\_

Rig up \_\_\_\_\_

Drilling and Remarks:

surface hole

#### RECORD

Cased \_\_\_\_\_ in., \_\_\_\_\_ ft.

Sand \_\_\_\_\_

Gas \_\_\_\_\_

Oil \_\_\_\_\_

Total Depth \_\_\_\_\_

#### PRODUCTION

1st 24 hrs. Nat. \_\_\_\_\_

1st 24 hrs. after shot \_\_\_\_\_

Gas \_\_\_\_\_ Cu. Ft.

Dry Hole \_\_\_\_\_

Abandoned \_\_\_\_\_

Date

DEC 29 1948 19

S. J. LEWIS Scout

*Shady Creek*

Map No. L 81 Sec. 35 Twp. 22 R. 16W.

Well No. 1 Galliant

Champion Ref. Company  
**COMPLETE**

NWSE Contractor  
E. 2016  
**SECTION PLAT**

230 Ft. from N. Line

\_\_\_\_\_ Ft. from S. Line

\_\_\_\_\_ Ft. from E. Line

330 Ft. from W. Line

		o	

*Pawnee*

Location \_\_\_\_\_

Rig up \_\_\_\_\_

Drilling and Remarks:

*Core # 4087  
5" @ 4078  
153 shots to 4087-65  
2500 acid  
40 M. Gun  
1136 #2/12*

**RECORD**

Cased \_\_\_\_\_ in., \_\_\_\_\_ ft.

Sand \_\_\_\_\_

Gas \_\_\_\_\_

Oil \_\_\_\_\_

Total Depth 4078

**PRODUCTION**

1st 24 hrs. Nat. \_\_\_\_\_

1st 24 hrs. after shot \_\_\_\_\_

Gas \_\_\_\_\_ Cu. Ft.

Dry Hole \_\_\_\_\_

Abandoned \_\_\_\_\_

Date

FEB 9 1949 19

S. J. LEWIS Scout