


Pawnee

SECTION 35 TOWNSHIP 22 RANGE 17 W

WELL NO. #3 Jennings

COMPANY Gulf Oil

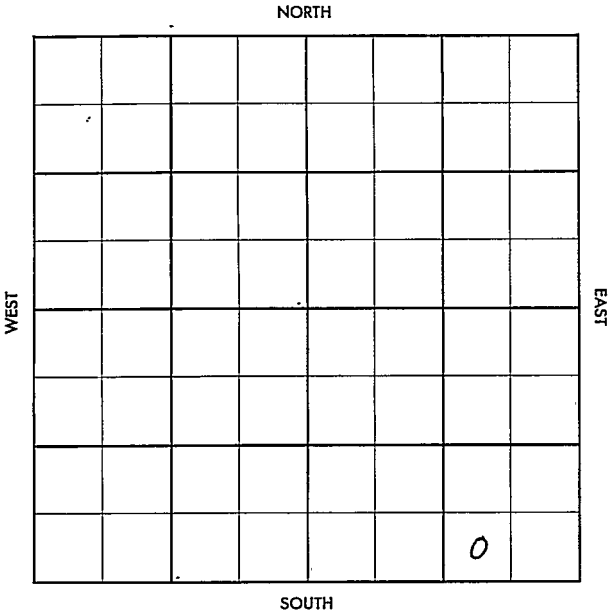

Pawnee

KANSAS

SEC. 35	TWP. 22	R. 17W
------------	------------	-----------

WELL NO.

#3 Jennings

FARM

COMPANY

Gulf Oil

CONTRACTOR

Honaker

Garfield


_____ Ft. from N. Line

_____ Ft. from S. Line

_____ Ft. from E. Line

_____ Ft. from W. Line

SW SE SE

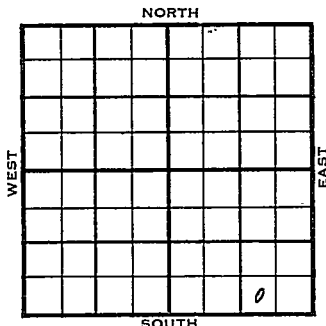

	ELEVATION	REPORT
1956		
1-11	Comm. 1-6-56 8" @ 1095/600 Drlg. 2090'	

County Pawnee Elev. _____
 Sec. 35 22 Rge. 17W
 Company Gulf Oil
 FarmName Vennings No. 3

Co.

Lse.

No.

Sec.

T.

R.

TOPS	DEPTH	LOG	DATUM
Anh.			
Tr.			
H.			
Tr.			
Dg.			
Bl.			
L.			
K.C.			
B.K.C.			
Ce.			
C.			
M.			
M.			
K.			
Mz.			
Mq.			
V.			
S.			
S.			
A.			
R.			
Pe.			
G.			
T.D.			

Loc. in Sec. _____

SW SE SE

Geol. _____

Contr. _____

Honaker

Pool _____

Garfield

JAN 11 '56

FIRST REPORT

0

Date Comm. 1-6-56
8" @ 1095/600 drlg. 2090

County Pawnee Elev. 2061
 Sec. 35 Twp. 22 Rge. 17W
 Company Gulf Oil
 Farm Name Jennings No. 3

TOPS	DEPTH	LOG	DATUM	Loc. in Sec.
Anh.				SW SE SE
Tr.				
H.	3593	3593		
Tr.				
Dg.				
Bl.	3701	3701	1640	
L.	3709	3710	1649	Geol.
K.C.		3990	1929	Contr.
BKC.				
Ce.				Honaker
B.P. 29	4136	4136	2095	
M.				Pool
M.				Garfield
K.				
Nr.				
Mo.				
V. chert	4213	4200	2139	
S.				
S.				
A.				
R.				
Pe.				
G.				
ED.	4250			

Date Comm. 1-6-56 FEB 1 5 1956

8" @ 1095/600 drlg. 2090 JAN 18 '56 ID 4160

JAN 25 '56 DST 4140-60 80" rec.

1240' GIP rec 40' GCM BHP

360/15" DST 4161-86 45" rec

55' Md BHP 210/30 DST 4214

-29 90" 90' GIP rec 51' 0'

GCM BHP 40/15" FEB 1 '56

FEB 8 '56

W & A (Hold)