

DX 78-1


Pawnee

KANSAS

Section 35 Township 22 Range 17W

Well No. #1 Redetzke

Company Westpan et al.

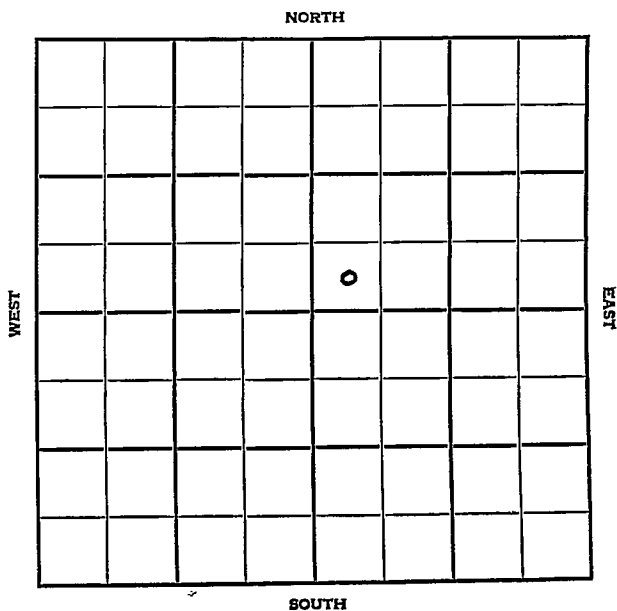


County Pawnee State ~~Kansas~~

Sec. 35 (Blk. Twp.) 22 (Sur. Rge.) 17W Map No.

Operator Westpan et al.

Well No. 1 Farm Redetzke

Elev. Location SW SWNE

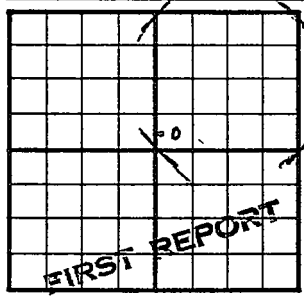

330 Ft. From S Line NE

330 Ft. From W Line Quarter

1st. Report JUN 1 1955

Completion

Remarks

Hilton - Contr.

Spudding Date 5-29-55

Garfield Pool

Drlg. Data

8" @ 227 drlg. 800

K-19

County Pawnee Elev. 2050
 Sec. 35 Twp. 22 Rge. 17W
 Company Hilton Drlg. & San Diego Corp.
 Farm Name Redetzke No. 1

TOPS	DEPTH	LOG	DATUM	Loc. in Sec.
Anh.				SW SW NE
TP.				
H.	<u>.3580</u>		<u>1530</u>	
Tr.				
Dg.				
Bl.	<u>.31088</u>		<u>11038</u>	
L.				
K.C.	<u>.3697</u>		<u>11047</u>	Geol. _____
B.K.C.				Contr. _____
Ce.				
C. <u>Sh</u>	<u>4104</u>		<u>2054</u>	Hilton
M. <u>Strong oil</u>	<u>4118</u>		<u>2068</u>	
M.				Pool
K.				Garfield
Mz.				
Me.				
V.	<u>4228</u>		<u>2178</u>	
S.				
S.				
A.				
R.				
PE.				
G.				
TD.	<u>4240</u>			

Date Comm. 5-29-55 JUL 6 1955

8" @ 227 DST 4117-35 open 1 hr.

Rec. 60' gcm 970/30" DST 4137-55

open 1 hr. Rec. 30' ocm 170' hocm

40' oil 15' wtr. 685#/30"

5 $\frac{1}{2}$ " @ 4238/150 CO to 4209 36/ 4142-48

frac 1,500 mcfg 36/ 4142-46 frac

SP 4149 24/ 4126-30 frac

Temp. abd.

Please check spot & description. They do not agree. Also, please send us a correction ticket on the Company name. This was first reported as Westpan et al as the Company Thanks.

Mickey, Scouting Dept.

Scout Cards	<i>mm</i>
Land Small Map	
Land Wall Map	
Tracings	
France Map	
Pierce Map	
Misc.	

JUL 18 1955