


Section 35 Township 22 Range 37 W

Well No. # 1 Kenneth Davis

Company Stanolind

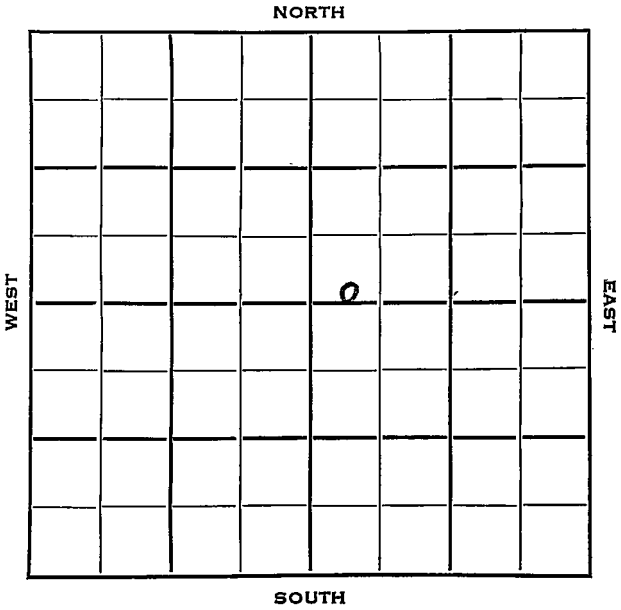


Kearny KANSAS

SEC.	TWP.	R.
35	22	37W

WELL NO. \_\_\_\_\_  
 1 Kenneth Davis FARM  
 COMPANY \_\_\_\_\_  
 Stanolind  
 CONTRACTOR \_\_\_\_\_

Hugoton Pool

\_\_\_\_\_ Ft. from N. Line  
 150 \_\_\_\_\_ Ft. from S. Line  
 \_\_\_\_\_ Ft. from E. Line  
 300 \_\_\_\_\_ Ft. from W. Line

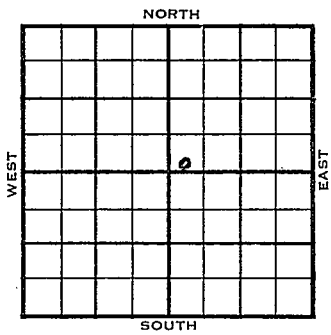

SW SW NE

	ELEVATION	REPORT
1953	3201'	
11/18	Location	
12/9	8" @ 770' w/500 RTD 2710' 5" @ 2700 Her 2550', Win 2600', Up Ft. 2660', Low Ft. 2699' CO 2710'	
12/16	WOCT	
1954 2/24	Spud 11-25-53 D & A TD 2720 8-5/8" @ 770 Her. 2550 Win. 2600 Ft. Riley 2660 TD 2710 5" @ 2700 CO to 2710 DD 2720 PB 2690 84/2666-80 frac. S/250 GSWPH CO to 2650 60/2600-10 46/2623-30 36/2614-20 frac 42/2561-68 30/2573-80 frac. D & A	
	<b>ABANDONED</b>	



County Kearny State Kansas

Sec. 35 (Blk.) 22 (Sur. Rge.) 37W Map No.

Operator Stanolind

Well No. 1 Farm Kenneth Davis

Elev. 3204 Location SW SW NE

<b>ABANDONED</b>									

150 Ft. From S Line NE

300 Ft. From W Line Quarter

Ist. Report

Completion FEB 24 1954

Remarks Hugoton Pool

Spudding Date 11-25-53

Drlg. Data D & A TD 2720

8 5/8" @ 770 Her. 2550 Win. 2600

Fr. Riley 2660 TD 2710 5" @ 2700

CO to 2710 DD 2720 PB 2690 84/ 2666-80

frac S/ 250 gswph CO to 2650 60/ 2600-

10 46/ 2623-30 36/ 2614-20 frac

42/ 2561-68 30/ 2573-80 frac

D & A

J. G. McGEHEE