

NORTH

WEST

EAST

SOUTH

Location_____

Drilling Remarks

Rig Up.

Drilling Remarks

RECORD

Cased _____ in. _____ ft.

Sand_____

Gas

Oil

Total Depth_____

PRODUCTION

1st 24 hrs. Nat. _____

1st 24 hrs. after shot_____

Gas_____cu. ft._____

Dry Hole_____

Abandoned_____


Map No. KANSAS Sec. 36 Twp. 22 R. 12^w
Well No. 36- Richardson Farm
Mid West Company

 Ft. from N. Line

330 Ft. from S. Line

330 Ft. from E. Line

19.30 Ft. from W. Line

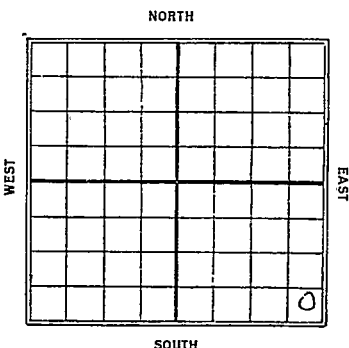

Date	REPORT
3/26	Bldg Rig
4/2	Spig
4/9	Rigging up.
4/16	20" 160' Speed
4/23	S.D. - 100'
4/30	—
5/7	Speed 185'
5/14	Bldg. 515'
5/21	" 950'
5/28	" 1820'
6/4	U.R. 10" - 2050'
6/11	77W 2165' - 75' run 10" - 2175'
6/18	Bldg. 2545'
6/25	U/R 10" - 2757'
7/2	2 1/2" gas 2757' - 2835' U/R 10" - 2835'
7/9	2835' Log. 10" Log
7/16	Sement 10" - 2845'
7/23	—

7/30 - Hrlg. 2955'

8/6 - " 3100'

8/13 - 8" - 3111'

8/20 - sledge 8"
show oil 3268
Est 4M gas 3305-08'

8/27 - T.D. 3390'

Rng 6" - show oil

9/3 - Rng 6" - 3475'

9/8 - Day 3541-44

Filled up 900 pt oil
in 2 hours

9/10 - T.D. 3545' Filled
up 3100' oil 16 hrs

Spao 418
Fighting Cave

9/17 - T.D. 3549

Swab 289 bbl 24 hr
with head

Swab 9 bbl per hr
after head swab off

9/24 - Swab 235 bbl

10/1 - Swab 245 bbl
24 hrs. Hrlg. 3587'

10/6 - Deepened some, do
not know how much
swab 340 bbl 6 hrs

10/8 - T.D. 3599

swab 750 bbl 17 hr

10/15 - S.D. 3599

Bldg loading rack

Map No. Rs Sec. 36 Twp. 22 R. 12^w
Well No. 36 - Richardson Farm
Mid West Company

NORTH


 Ft. from N. Line

330 Ft. from S. Line

330 Ft. from E. Line

1930 Ft. from W. Line

WEST

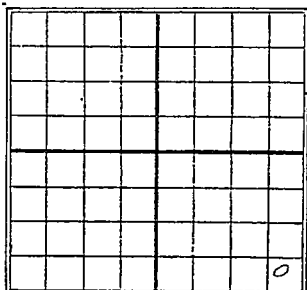

SOUTH

Date

REPORT

10/22 Sand 3541-99
FD. 3599
swab 1000 bbl oil
Comp.

Stafford
 Map No. *KANSAS*


Sec. *36* Twp. *22* R. *12 W.*

Well No. *46* *36 Richardson*

Mid West Company

Contractor

SECTION PLAT

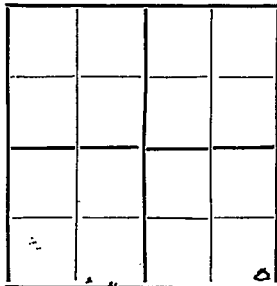

..... Ft. from N. Line

220 Ft. from S. Line

330 Ft. from E. Line

..... Ft. from W. Line

FIRST REPORTS

Location.....

Rig up.....

Drilling and Remarks:

Building rig

RECORD

Cased..... in., ft.

Sand.....

Gas.....

Oil.....

Total Depth.....

PRODUCTION

1st 24 hrs. Nat.....

1st 24 hrs. after shot.....

Gas..... Cu. Ft.

Dry Hole.....

Abandoned.....

Date

MAR 26 1930

S. J. LEWIS Scout

Map No. KANSAS Sec. 36 Twp. 22 R. 12W

Well No. 36 Richardson

Mid West. Company

Contractor

SECTION PLAT

_____ Ft. from N. Line

220 Ft. from S. Line

230 Ft. from E. Line

_____ Ft. from W. Line

			0

COMPLETED

RECORD

Location _____

Cased _____ in., _____ ft.

Rig up _____

Sand 3541 - 3599

Drilling and Remarks _____

Gas _____

Oil _____

Total Depth 3599

PRODUCTION

1st 24 hrs. Nat. _____

1st 24 hrs. after shot _____

Gas _____ Cu. Ft.

Dry Hole _____

Abandoned _____

Date

OCT 22 1930

S. J. LEWIS Scout