


Section 36 Township 22 Range 13 W

Well No. #1 Durham

Company Arnold Kimmis

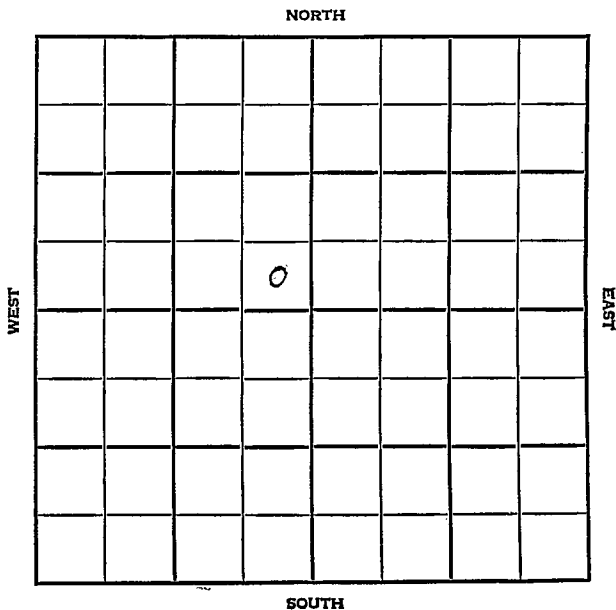

Stafford

KANSAS

SEC. 36-	TWP. 22	R. 13W
-------------	------------	-----------

WELL NO.

#1 Durham

FARM

COMPANY

Arnold Kimmis

CONTRACTOR

Rocket

Clarksburg


\_\_\_\_\_ Ft. from N. Line

\_\_\_\_\_ Ft. from S. Line

\_\_\_\_\_ Ft. from E. Line

\_\_\_\_\_ Ft. from W. Line

SE SE NW

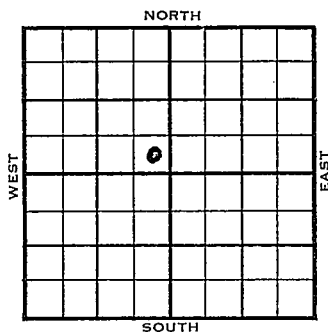

1955	ELEVATION 1883'	REPORT <b>FIRST REPORT</b>
------	--------------------	-------------------------------

8/10

Comm: 8-5-55

8" @251/175 Drlg: 2100

Anh. 725

8-24 DST 3514-25, open  $\frac{1}{2}$  hr. Rec. 10' mud  
560/20"

DST 3534-56, open 1 hr., Rec. 15' mud

DST 3575-90 open  $\frac{1}{2}$  hr., Rec. 30' mud  
70/20"

# D &amp; A

~~8-24~~ Anh. 725, H. 3236, 1353, Tr. 3256, 1373,  
B.L. 3371, 1488, K.C. 3389, 1506, V. 3696,  
1813, S. 3747, 1864, A 3806, 1923, T.D.  
3846.

**ABANDONED**

County Stafford Elev. \_\_\_\_\_  
 Sec. 36 Twp. 22 Rge. 13W  
 Company Arnold/Kimmis  
 FarmName Durham No. 1

TOPS	DEPTH	LOG	DATUM
Anh.	725		
Tp.			
H.			
Tr.			
Dg.			
Bl.			
L.			
K.C.			
B.K.C.			
Ce.			
C.			
M.			
M.			
K.			
Mz.			
Ma.			
V.			
S.			
S.			
A.			
R.			
PE.			
G.			
T.D.			

Loc. in Sec. SE SE NW  
 Geol. \_\_\_\_\_  
 Contr. \_\_\_\_\_  
Rocket  
 Pool Clarksburg

AUG 14 '55  
 D  
 FIRST REPORT

Date Comm. 8-5-55  
8" @ 251/175 drlg. 2100

*[Handwritten signature]*

Co.  
 Lse.  
 No.  
 Sec.  
 T.  
 R.

X

County Stafford Elev. 1883

Sec. 36 Twp. 22 Rge. 13W

Company Arnold Kimmis

Farm Name Durham No. 1

TOPS	DEPTH	LOG	DATUM	Loc. in Sec.
Anh.	<u>725</u>			SE SE NW
Tr.				
H.	<u>3236</u>		<u>1353</u>	
Tr.	<u>3256</u>		<u>1373</u>	
Dg.				
Bl.	<u>3371</u>		<u>1488</u>	
L.				
K.C.	<u>3389</u>		<u>1506</u>	Geol. _____
B.K.C.				Contr. _____
Ce.				
C.				Rocket Drlg.
M.				
M.				Pool
K.				
Mz.				Clarksburg
Me.				
V.	<u>3696</u>		<u>1813</u>	
S.	<u>3747</u>		<u>1864</u>	
S.				
A.	<u>3806</u>		<u>1923</u>	
R.				
PE.				
G.				
T.D.	<u>3846</u>			

Date Comm. 8-5-55 AUG 24 1955

8" @ 251/175 DST 351 $\frac{1}{2}$ -25 open  $\frac{1}{2}$  hr.

Rec. 10' mud 560/20" DST 353 $\frac{1}{2}$ -56

open 1 hr. Rec. 15' mud DST 3575-90

open  $\frac{3}{8}$  hr. Rec. 30' mud 70/20"

D & A