

DX 78-1 STAFFORD


KANSAS

Section 36 Township 22 Range 13W

Well No. 1 Long _____

Company Arnold Kimmis & World Uranium

NORTH

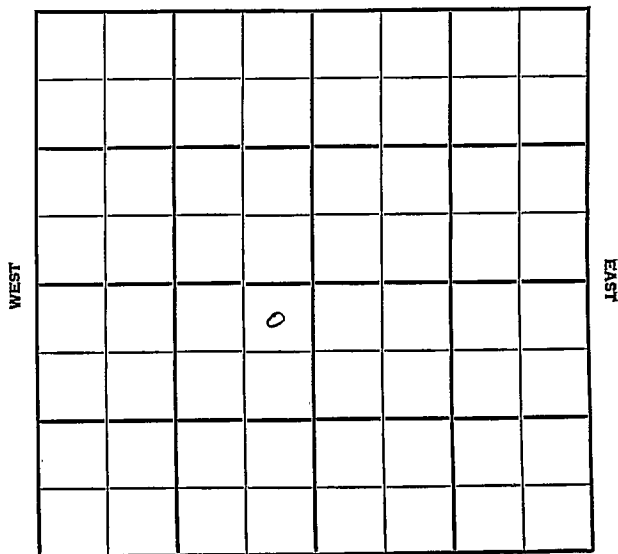

SOUTH

Stafford

KANSAS

HOT FILE

SEC.

TWP.

R.

36

22

13W

WELL NO.

#1 Long

FARM

COMPANY

Arnold Kimmis & World Uranium

CONTRACTOR

Shawver-Armour

Wildcat.

330


Ft. from N. Line

Ft. from S. Line

330

Ft. from E. Line

Ft. from W. Line

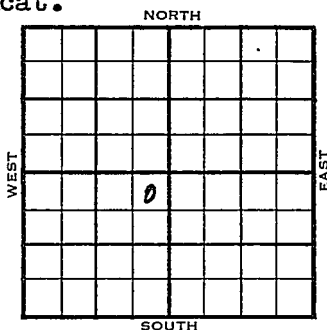

NE NE SW

(1/2 mile Sunray)

ELEVATION

REPORT

1955

1880'

3/30

Location

5/26

NR

6/2

Spud 4-7-55 Heeb 3234, Br. line 3370
KC 3388, Simp 3740, Arb. 3801.
TD 3813. 500 A
Comp. 237 BOPD

6/1

Comm 4-7-55
H 3234, BL 3370, KC 3388, S 3740,
A 3801, TD 3813
TOPS: KC 3388, S 3694, S 3740,
A 3800,
8" @ 256/255 DST 3555-84,
open 1 hr. Rec 700' free gco 700'
gco 1200/30" DST 3802-13 open 1 hr
Rec 1800' sw 1200/30" 5 1/2" @ 3812/100
Co 40/3701-11 24/3576-82 S/21 bo
11 hr 500 A S/13 boph
Comp 237 bopd

COMPLETED

FABEN GILSTRAP

County Stafford Elev. 1880
 Sec. 36 Twp. (22) Rge. 13W
 Company Arnold Kimmis & World Uranium
 Farm Name Long No. 1

TOPS	DEPTH	LOG	DATUM	Loc. in Sec.
Anh.				NE NE SW
T.P.				
H.	<u>3234</u>		<u>1354</u>	
Tr.				
Dg.				
Bl.	<u>3370</u>		<u>1490</u>	
L.				
K.C.	<u>3388</u>	<u>3388</u>	<u>1508</u>	Geol.
B.K.C.				Contr.
Ce.				Shawver-Armour
C.				
M.				Pool
M.				Wildcat
K.				
Mz.				
Me.				
V.				
S.	<u>3740</u>	<u>3694</u>	<u>1814</u>	COMPLETE
S.		<u>3740</u>	<u>1860</u>	
A.	<u>3801</u>	<u>3800</u>	<u>1920</u>	
R.				
Pe.				
G.				
T.D.	<u>3813</u>		<u>1933</u>	

Date Comm. 4-7-55 JUN 1 1955

8" @ 256/255 DST 3555-84 open 1 hr.

Rec. 700' free gco 700' gco 1200/30"

DST 3802-13 open 1 hr. Rec. 1800' sw

1200/30" 5 $\frac{1}{2}$ " @ 3812/100 CO

40/ 3701-11 24/ 3576-82 S/ 21 bo 11 hr.

500 A S/ 13 boph

Comp. 237 bopd