

KARST

Stafford

Section 36 Township 22 Range 14W

Well No. 1 Beaver

Company Sinclair Oil & Gas

Hart

NORTH

WEST

EAST

| | | | | | | | |
|--|--|--|---|--|--|--|--|
| | | | | | | | |
| | | | | | | | |
| | | | | | | | |
| | | | 0 | | | | |
| | | | | | | | |
| | | | | | | | |
| | | | | | | | |
| | | | | | | | |

SOUTH

Sec. 36 Twp. 22 R. 14W

Well No. #1 Beaver Farm _____

Sinclair Oil & Gas

Company _____

Hart Pool


_____ Ft. from N. Line

330' Ft. from S. Line

330' Ft. from E. Line

_____ Ft. from W. Line

SE NW

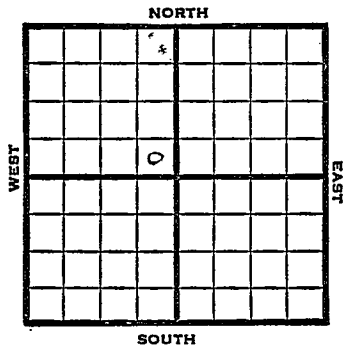

1949 Elev. 1931' REPORT

9/21 Location
 9/28 8" @ 455'
 Drlg 2250'
 10/5 Lansing 3463'
 Viola 3764'
 Arb. 3845'
 Drlg 3860'
 10/12 TD 3935'
 5" @ 3934'
 10/19 " " "
 10/26 Viola 3764'
 Simp 3789'
 Arb 3845'
 5" @ 3934'
 Perf Simp
 Acid 2000
 Pump 377 oil & 3% W Pot.
 Gr. 40°
 TD 3935'

COMPLETED

Kansas

Map No. _____ Sec. 36 Twp. 22 R. 14WWell No. 1 Beaver

Sinclair Oil & Gas Company

Contractor


SE NW

FIRST REPORT
SECTION PLAT

_____ Ft. from N. Line

330 Ft. from S. Line330 Ft. from E. Line

_____ Ft. from W. Line

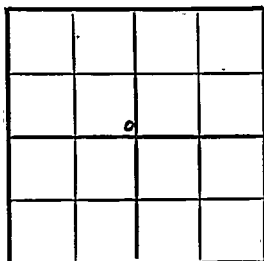

Stafford County

RECORD

Location X

Cased _____ in., _____ ft.

Rig up _____

Sand _____

Drilling and Remarks:

Gas _____

Oil _____

Total Depth _____

PRODUCTION

1st 24 hrs. Nat. _____

1st 24 hrs. after shot _____

Gas _____ Cu. Ft.

Dry Hole _____

Abandoned _____

Date

SEP 21 1949 19S. J. LEWIS Scout

Kansas

Hart Pool

Map No. _____ Sec. 36 Twp. 22 R. 14W

Well No. 1 Beaver

Sinclair-Prairie

Company

COMPLETE

Contractor

SE NW


E 1, 1931.
SECTION PLAT

_____ Ft. from N. Line

330 _____ Ft. from S. Line

330 _____ Ft. from E. Line

_____ Ft. from W. Line

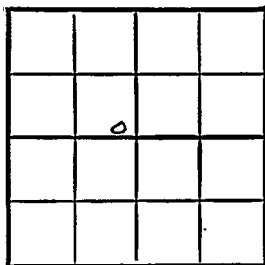

Stafford County

Location _____

Rig up _____

Drilling and Remarks:

*Wells 3764**Simp 3789**Co. 3545**5" @ 3934**Prof Simp**2000 acid**Pump 377 oil + 378**Dot 40 @ 200*

Date

RECORD

Cased _____ in., _____ ft.

Sand _____

Gas _____

Oil _____

Total Depth *3725*

PRODUCTION

1st 24 hrs. Nat. _____

1st 24 hrs. after shot _____

Gas _____ Cu. Ft.

Dry Hole _____

Abandoned _____

OCT 26 1949 19

S. J. LEWIS

Scout