


DX 78-1

Section 36 -- Township 22 Range 11W
 Well No. 1 Shirley Beaver
 Company Fleming & Woodman

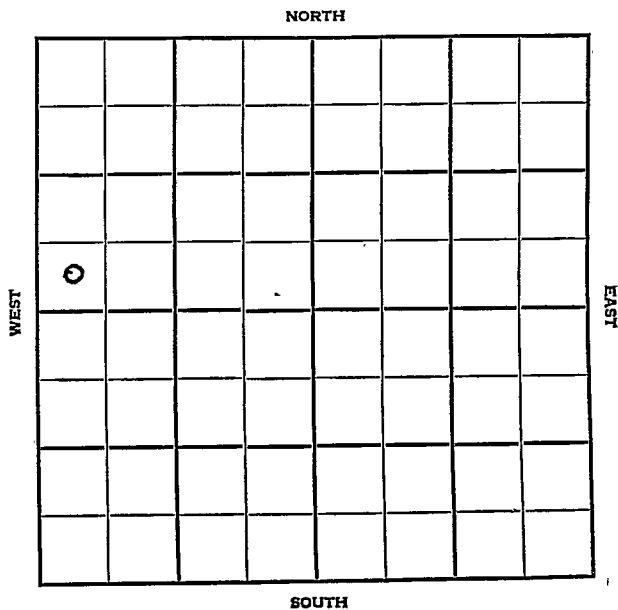

Stafford KANSAS

SEC.	TWP.	R.
36	22	14 W

WELL NO. # 1 Shirley Beaver FARM

COMPANY Fleming & Woodman

CONTRACTOR Fleming & Woodman

Wildcat


_____ Ft. from N. Line

330 _____ Ft. from S. Line

_____ Ft. from E. Line

200 _____ Ft. from W. Line


SW SW NW

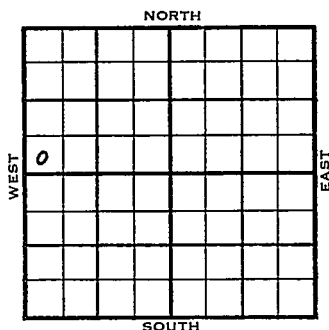

	ELEVATION	REPORT
1954	1925'	
6/23	Spud 6-18-54 8" @ 230' Anhy 835'	
6/30	Drlg. 1775' Heeb 3328 Br li 3457 Lans 3473 Cong 3755 V 3769 Simp 3800 Arb. 3854 Drlg. 3865'	
7/7	NR	
7/14	Spud 6-18-54 - D&A TD 3880' 8" @ 230' Anhy 835', Heeb 3328', Br lime 3457', Lans 3473', Cong 3755', Viola 3769', Simp. 3800', Arb. 3854' TD 3880' D&A	

COMPLETED


ABANDONED

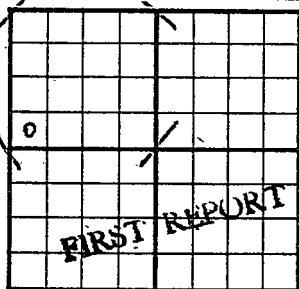County **Stafford** State **Kansas**Sec. **36** (Blk. Twp.) **22** (Sur. Rge.) **14W** Map No.Operator **Fleming & Woodman**Well No. **1** Farm **Shirley Beaver**Elev. Location **SW SW NW****330** Ft. From **S** Line **NW****200** Ft. From **W** Line Quarter1st. Report **JUN 23 1954**

Completion

Remarks

Fleming & Woodman - Contr.Spudding Date **6-18-54**Drlg. Data **Wildcat****8" @ 230 Anhy 835 drlg. 1775**

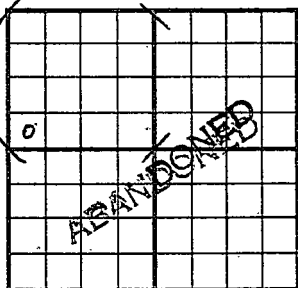County Stafford State KansasSec. 36 (Blk. 22 (Sur. 14W Map No.Operator Fleming & WoodmanWell No. 1 Farm Shirley BeaverElev. 1925 Location SW SW NW330 Ft. From S Line NW200 Ft. From W Line Quarter

1st. Report

Completion JUL 14 1954Remarks WildcatFleming & Woodman - Contr.Spudding Date 6-18-54Drlg. Data D & A TD 38808" @ 230 Anhy 835 Heeb. 3328Br. lime 3457 Lans. 3473 Cong. 3755Viola 3769 Simp. 3800 Arb. 3854TD 3880D & A

J. G. McGEHEE