

Stafford **KANSAS**

Sec. 36 Twp. 22 R. 14W

Well No. #1 Hart Farm

Musgrove Pet.

Company

Wilcoat (A B & W Drlg., Cont.)

NORTH

 Ft. from N. Line

330'


 Ft. from S. Line

 Ft. from E. Line

330'

 Ft. from W. Line

SW NE

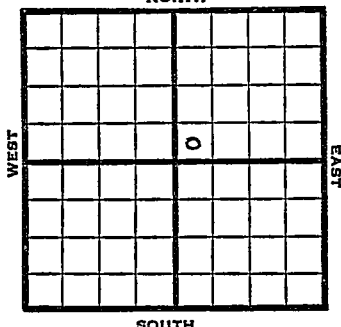

1949

Elev 1926'

R E P O R T

7/6

8" @ 320'

Drlg. 1650'

7/12

Lansing 3462'

Drlg. 3591'

7/20

Viola 3747'

Simp 3775'

Arb. 3826'

TD 3832'

5" @ 3830'

500 acid

Swb 20 bbls oil 3 hrs.

3/27

"

8/3

"

8/10

"

8/17

"

8/24

TD 3832'

Arb. 3826'

5" @ 3830'

500 acid

Pump 472 oil / 9% W Pot

35° Gr.

Comp

COMPLETED

Kansas

Map No. _____ Sec. 36 Twp. 22 R. 14W

Well No. 1 Hart

Musgrove Pet. _____ Company

A B & W drlg. _____ Contractor

SW NE


FIRST REPORT
SECTION PLAT

_____ Ft. from N. Line

330 _____ Ft. from S. Line

_____ Ft. from E. Line

330 _____ Ft. from W. Line

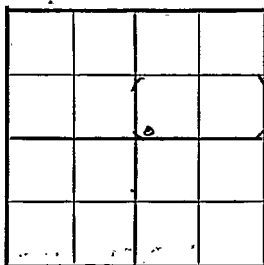

Stafford County

Location _____

Rig up _____

Drilling and Remarks:

8" @ 320

drlg. 1650

RECORD

Cased _____ in _____ ft.

Sand _____

Gas _____

Oil _____

Total Depth _____

PRODUCTION

1st 24 hrs. Nat. _____

1st 24 hrs. after shot _____

Gas _____ Cu. Ft.

Dry Hole _____

Abandoned _____

Date

JUL 6 1949

19

S. J. LEWIS

Scout

Map No. 1882 Sec. 36 Twp. 22 R. 14W

Well No. 1 Hart

Musgrove Pet.


Company

COMPLETE

Contractor

SW NE

E 1, 1926
SECTION PLAT

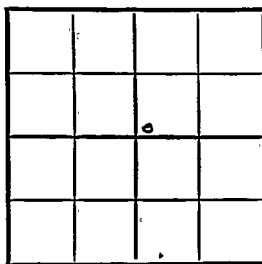

Ft. from N. Line

330

Ft. from S. Line

Ft. from E. Line

330

Ft. from W. Line

Stafford County

Location

Rig up

Drilling and Remarks:

Cr. 3826

5" @ 3830

5000 ac

Prod 472 oil +

7% W.B.T.

25 2/3

RECORD

Cased _____ in., _____ ft.

Sand _____

Gas _____

Oil _____

Total Depth 3832

PRODUCTION

1st 24 hrs. Nat. _____

1st 24 hrs. after shot _____

Gas _____ Cu. Ft.

Dry Hole _____

Abandoned _____

Date

AUG 24 1949 19

S. J. LEWIS Scout