


**KANSAS**

Section 36 Township 22 Range 14-W

Well No. #2 Hart

Company Musgrove Pet.  
Hart Pool

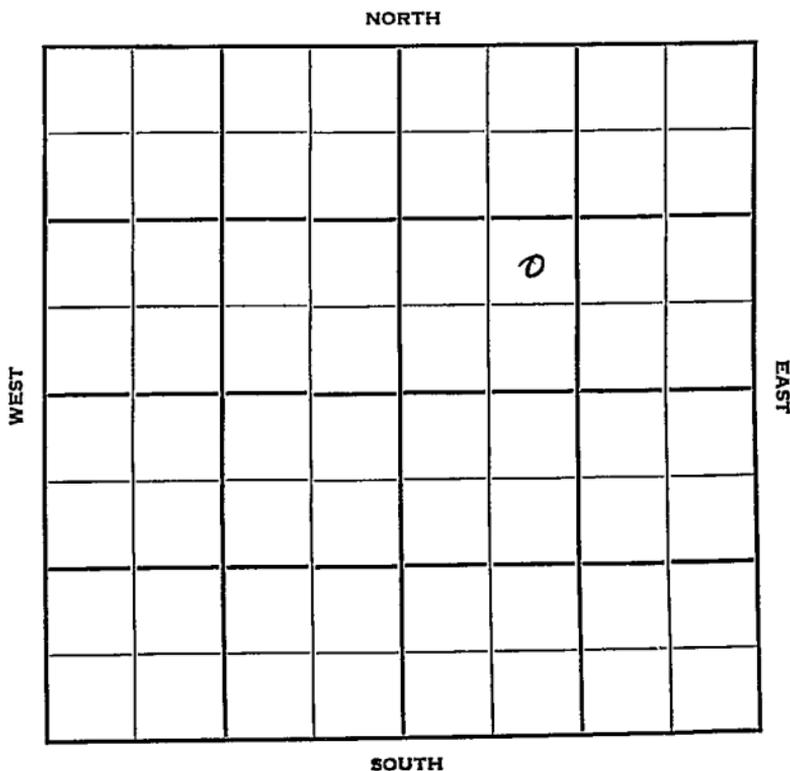

Sec. 36 Twp. 22 R. 14W

Well No. #2 Hart Farm

Musgrove Pet. Company

Hart Pool Contractor


           Ft. from N. Line

990' Ft. from S. Line

           Ft. from E. Line

990' Ft. from W. Line

NE SW NE

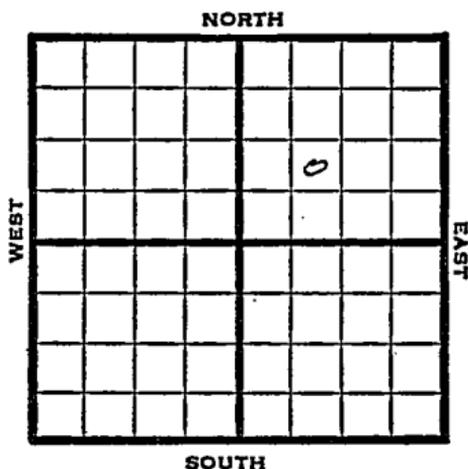

1950 Elev. 1929' REPORT

3/8 Location

5/10 TD 3847

8" @ 327

Lans 3457

Cong 3744

Viola 3749

Simp 3790

Anb 3839

5" @ 3689

perf 30/3646-51 had a slight show of oil

Dry and abandoned

**ABANDONED**

Kansas

Map No. \_\_\_\_\_ Sec. 36 Twp. 22 R. 14W

Well No. 2 Hart

Musgrove Pet. \_\_\_\_\_ Company

\_\_\_\_\_ Contractor

El. 1929

NE SW NE

SECTION PLAT

\_\_\_\_\_ Ft. from N. Line

990 Ft. from S. Line

\_\_\_\_\_ Ft. from E. Line

990 Ft. from W. Line

		0	

FIRST REPORT

Stafford County

Location \_\_\_\_\_ X

Rig up \_\_\_\_\_

Drilling and Remarks:

RECORD

Cased \_\_\_\_\_ in., \_\_\_\_\_ ft.

Sand \_\_\_\_\_

Gas \_\_\_\_\_

Oil \_\_\_\_\_

Total Depth \_\_\_\_\_

PRODUCTION

1st 24 hrs. Nat. \_\_\_\_\_

1st 24 hrs. after shot \_\_\_\_\_

Gas \_\_\_\_\_ Cu. Ft.

Dry Hole \_\_\_\_\_

Abandoned \_\_\_\_\_

Date

MAR 8 1950 19

J. E. TYRA

Scout



perf 30/3646-5 had  
a slight show of oil

DfA

MAY 19 1950

- Scout Cards 20
- Land Small Map 3
- Land Wall Map 3
- Tracings 3
- France Map 3
- Pierce Map 3
- Misc. 3

Handwritten notes and scribbles, including the word "INDEX" and various illegible markings.