

KANSAS


Reno

FORM 51 5M 10-41 PETROL

Section 26 Township 22 Range 9-W

Well No. #1 Wipf


Company Texas

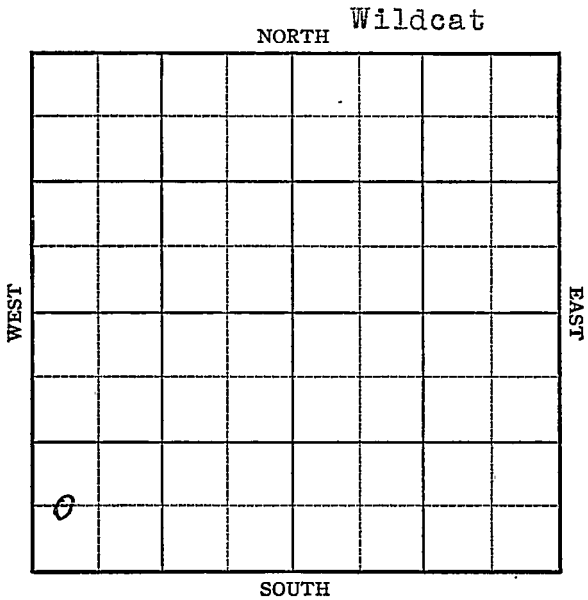

Sec. 36 Twp. 22 R. 9-WWell No. #1 Wipf FarmTexas

Company

(Wildcat)

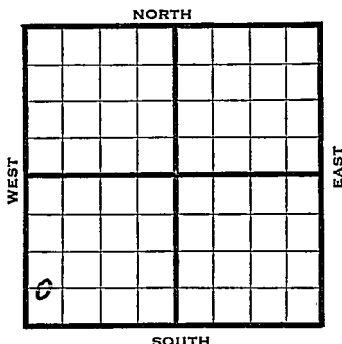 Ft. from N. Line660 Ft. from S. Line Ft. from E. Line330 Ft. from W. Line*Elv. 1712*

1942

REPORT

7/8	Location	
7/15	10" - 215'	Drlg. 1335'
7/22	Drlg. 3020'	
7/29	Lans. 3178	Miss Chat. 3600'
	Drlg. 3650'	
8/5	Kind. 3647	Viola 3864
	Simp. 3885	Arb. 3956
	T.D. 3984 No shows	
	Shut down.	
8/12	PB 3670 5" @ 3601 200 acid	
	5 gal per hr 60 water PB 3575	
8/19	Arb. 3956	5" - 3601
	Water.	
	T.D. 3984	

ABANDONED

Ren o

KANSAS

Map No. 49 Sec. 36 Twp. 22 R. 9WWell No. 1 Wipf

Texas

Company

FIRST REPORT

Contractor

C WL SW SW.


Ft. from N. Line

660 Ft. from S. Line

Ft. from E. Line

330 Ft. from W. Line

SECTION PLAT

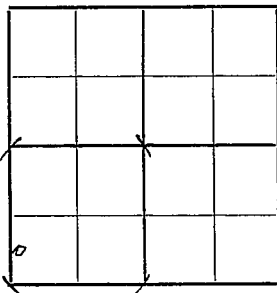

WILDCAT

Location XX

Rig up

Drilling and Remarks:

RECORD

Cased _____ in., _____ ft.

Sand _____

Gas _____

Oil _____

Total Depth _____

PRODUCTION

1st 24 hrs. Nat. _____

1st 24 hrs. after shot _____

Gas _____ Cu. Ft.

Dry Hole _____

Abandoned _____

Date

JUL 8 1942

19

S. J. LEWIS Scout

Map No. 49 Sec. 36 Twp. 22 R. 9WWell No. 1 WipfTexas CompanyABANDONED Contractor

C WL SW SW

SECTION PLAT

 Ft. from N. Line660 Ft. from S. Line Ft. from E. Line330 Ft. from W. Line

6			

WILDCAT

Location Rig' up

Drilling and Remarks:

*Cr 43956.**5" C3601**Water.*

RECORD

Cased in., ft.Sand Gas Oil Total Depth 3874

PRODUCTION

1st 24 hrs. Nat. 1st 24 hrs. after shot Gas Cu. Ft.Dry Hole Abandoned

Date

AUG 1 9 1942 19 S. J. LEWIS Scout