

KANSAS

Reno


FORM 51 5M 4-41 PETROL

Section 36 Township 22 Range 10-W

Well No. #1 Potter

Company Transwestern

NORTH Peace Creek Pool

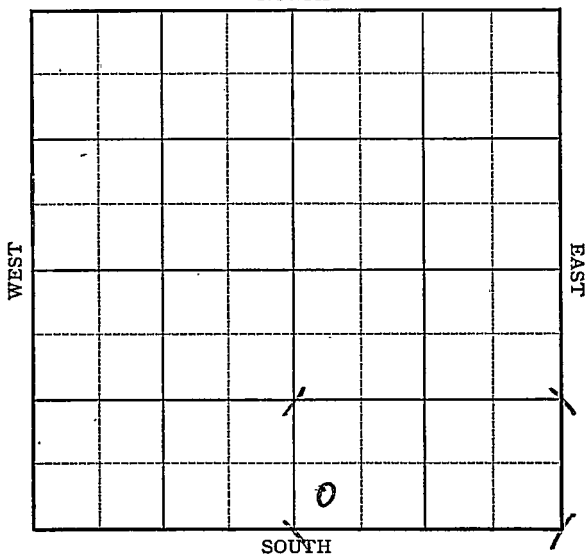

Sec. 36 Twp. 22 R. 10-W

Well No. #1 Potter Farm

Transwestern Company.

(Peace Creek)


 Ft. from N. Line

330 Ft. from S. Line

 Ft. from E. Line

330 Ft. from W. Line

Elv. 1737

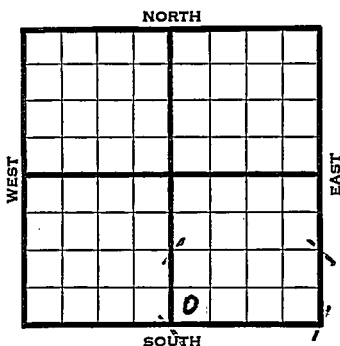

1942

REPORT

6/3

Location

6/10

Drlg. 1355'

6/17

Drlg. 3300'

6/24

Lans. 3210' Viola 3683-90' T.D.

5" - 3687' RUST.

7/1

T.D. 3725' 600' oil, trace water.

2000 acid.

7/8

Viola 3683'

5" - 3687'

T.D. 3725'

2000 acid.

Pump 268 oil & 69 water.

42. Gravity

COMPLETED

Map No. 46 Sec. 36 Twp. 22 R. LOWWell No. 1 PotterTranswestern


Company

FIRST REPORT

Contractor

SW SE

SECTION PLAT

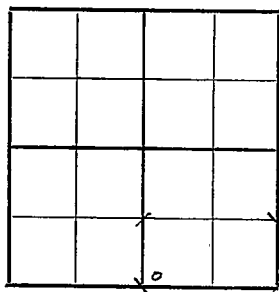

Ft. from N. Line

330

Ft. from S. Line

Ft. from E. Line

330

Ft. from W. Line

PEACE CREEK POOL

Location XX

Rig up

Drilling and Remarks:

RECORD

Cased _____ in., _____ ft.

Sand _____

Gas _____

Oil _____

Total Depth _____

PRODUCTION

1st 24 hrs. Nat. _____

1st 24 hrs. after shot _____

Gas _____ Cu. Ft.

Dry Hole _____

Abandoned _____

Date

JUN 3 1942 19S. J. LEWIS

Scout

KANSAS

Reno

Map No. 46 Sec. 36 Twp. 22 R. 10WWell No. 1 Potter

Transwestern

Company

COMPLETED

Contractor

S N S E

SECTION PLAT

_____ Ft. from N. Line

330 Ft. from S. Line

_____ Ft. from E. Line

330 Ft. from W. Line

PEACE CREEK POOL

Location _____

Rig up _____

Drilling and Remarks:

Vid 1a 36835" @ 36872000 AcidPump 268 oil +69 Water420 / 9

RECORD

Cased _____ in., _____ ft.

Sand _____

Gas _____

Oil _____

Total Depth 3725

PRODUCTION

1st 24 hrs. Nat. _____

1st 24 hrs. after shot _____

Gas _____ Cu. Ft.

Dry Hole _____

Abandoned _____

Date

JUL 8

1942 19

S. J. LEWIS

Scout