


Section 36 Township 22 Range 10-W

Well No. #1 Ramsey

Company Transwestern

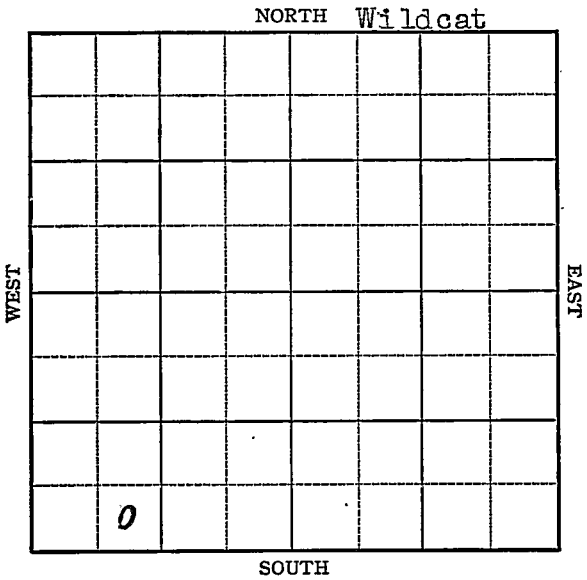

KANSAS

Reno

Map No. 46 Sec. 36 Twp. 22 R. 10WWell No. 1 Ramsey

Transwestern


Company

FIRST REPORT

Contractor

SE SW SW

SECTION PLAT

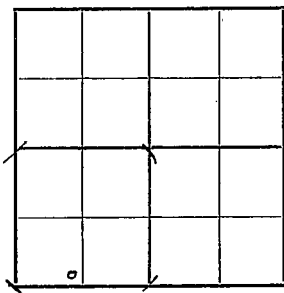

_____ Ft. from N. Line

330 Ft. from S. Line

_____ Ft. from E. Line

990 Ft. from W. Line**WILDCAT**

Location _____

Rig up _____

Drilling and Remarks:

Surface Hole

RECORD

Cased _____ in., _____ ft.

Sand _____

Gas _____

Oil _____

Total Depth _____

PRODUCTION

1st 24 hrs. Nat. _____

1st 24 hrs. after shot _____

Gas: _____ Cu. Ft.

Dry Hole _____

Abandoned _____

Date

APR 15 1942 19S. J. LEWIS Scout

Reno

KANSAS

Map No. 46 Sec. 36 Twp. 22 R. 10W

Well No. 1 Ramsey

Transwestern Company

COMPLETED Contractor

SE SW SW

SECTION PLAT

_____ Ft. from N. Line

330 Ft. from S. Line

_____ Ft. from E. Line

990 Ft. from W. Line

WILDCAT

RECORD

Location _____

Cased _____ in., _____ ft.

Rig up _____

Sand _____

Drilling and Remarks:

Gas _____

Vista 8656

Oil _____

5" @ 3691

Total Depth 3702

2000 rods

Bond # 41635

May 3000

PRODUCTION

1st 24 hrs. Nat. _____

1st 24 hrs. after shot _____

Gas _____ Cu. Ft.

Dry Hole _____

Abandoned _____

Date

MAY 20 1942 19

S. J. LEWIS Scout