


Section 36 Township -22 Range 10W

Well No. 1 Potter

Company Pickrell Drlg. et al  
Peace Creek Pool

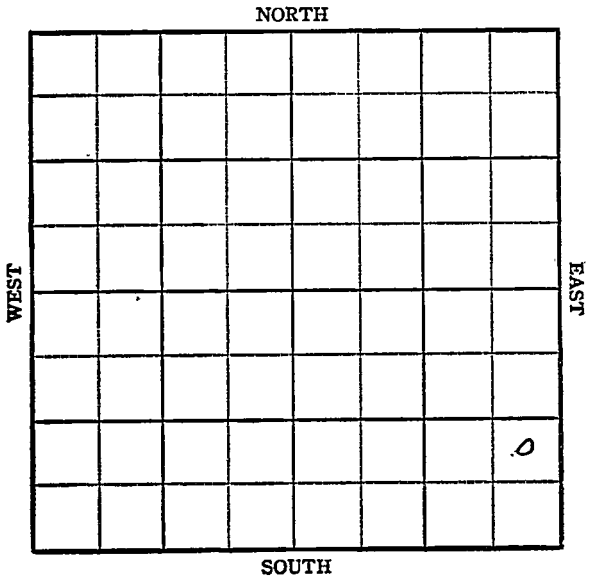

KANSAS

Reno

**HOT FILE** ✓

Sec. 36 Twp. 22 R. 10W

Well No. #1 Potter Farm

Pickrell Drlg. et al Company

Peace Creek Pool

NORTH


           Ft. from N. Line

990' Ft. from S. Line

330' Ft. from E. Line

           Ft. from W. Line

. NE SE SE

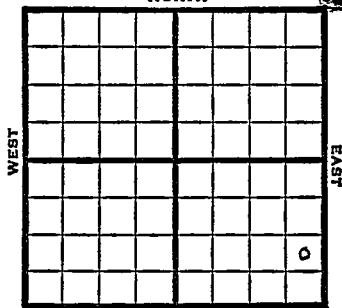

SOUTH

1948 Elev. 1737' REPORT

12/8 8" @ 228'  
Anhy. 625'  
Drlg. 3580'

12/22 Lansing 3214'  
Viola 3684'  
5" @ 3687'  
TD 3717  
2,500 acid

12/29 Swb 10 bbls oil PH - 8 hrs  
SSW

1949

1/5 Viola 3684'  
5" @ 3687'  
3500 acid  
Pump 75 oil Pot.  
Gr. 42°  
TD 3717'

**COMPLETED**

Map No. \_\_\_\_\_ Sec. 36 Twp. 22 R. 10W

Well No. 1 Potter

Pickrell Drlg. etal. Company

**FIRST REPORT**

Contractor

NE SE SE

**SECTION PLAT**

\_\_\_\_\_ Ft. from N. Line

990 Ft. from S. Line

330 Ft. from E. Line

\_\_\_\_\_ Ft. from W. Line


Reno County

Location \_\_\_\_\_

Rig up \_\_\_\_\_

Drilling and Remarks:

8" @ 228

Anhy 625

drlg. 3580

**RECORD**

Cased \_\_\_\_\_ in., \_\_\_\_\_ ft.

Sand \_\_\_\_\_

Gas \_\_\_\_\_

Oil \_\_\_\_\_

Total Depth \_\_\_\_\_

**PRODUCTION**

1st 24 hrs. Nat. \_\_\_\_\_

1st 24 hrs. after shot \_\_\_\_\_

Gas \_\_\_\_\_ Cu. Ft.

Dry Hole \_\_\_\_\_

Abandoned \_\_\_\_\_

Date

DEC 8 1948

19

S. J. LEWIS

Scout

Map No. 46 Sec. 36 Twp. 22 R. 10W

Well No. 1 Potter

Pickrell Drlg. etal. Company

**COMPLETE**

Contractor

NE SE SE

*E 11737*

**SECTION PLAT**

\_\_\_\_\_ Ft. from N. Line

990 Ft. from S. Line

330 Ft. from E. Line

\_\_\_\_\_ Ft. from W. Line

			0

Reno County

Location \_\_\_\_\_

Rig up \_\_\_\_\_

Drilling and Remarks:

*Vista 8687*  
*5" @ 8687*  
*3500 acd*  
*Pump Oil*  
*42°*

**RECORD**

Cased \_\_\_\_\_ in., \_\_\_\_\_ ft.

Sand \_\_\_\_\_

Gas \_\_\_\_\_

Oil

Total Depth 2217

**PRODUCTION**

1st 24 hrs. Nat. \_\_\_\_\_

1st 24 hrs. after shot \_\_\_\_\_

Gas \_\_\_\_\_ Cu. Ft.

Dry Hole \_\_\_\_\_

Abandoned \_\_\_\_\_

Date

JAN 5 1949 19

S. J. LEWIS Scout