


Map No. KANSAS Sec. 36 Twp. 22 R. 2

Well No. 1-Edman Farm
Jones & Shell Lbr Company

NORTH

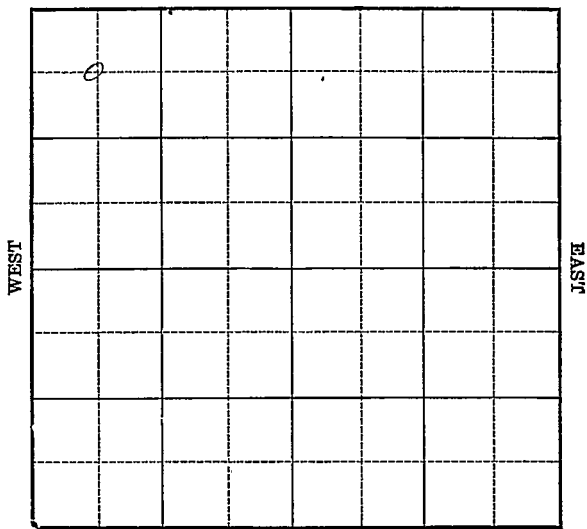

SOUTH

Location _____
Drilling Remarks _____

Rig Up _____
Drilling Remarks

RECORD

Cased _____ in. _____ ft.

Sand_____

Gas

Oil

Total Depth.....

PRODUCTION

1st 24 hrs. Nat. _____

1st 24 hrs. after shot_____

Gas_____cu. ft._____

Dry Hole.....

Abandoned

Map No. KANSAS Sec. 36 Twp. 22 R. 2^w

Well No. 1-Lehman Farm

Jones & Shell Company

NORTH

WEST

EAST

SOUTH

660 Ft. from N. Line

_____ Ft. from S. Line

_____ Ft. from E. Line

660 Ft. from W. Line

1930

Date

REPORT

11/5	Loc
11/12	—
11/19	—
11/25	—
12/3	—
12/10	—
12/17	—
12/23	—
12/30	Ray
1931	
1/7	—
1/14	—
1/21	Found
1/28	dreg 540'
2/4	" 1030'
2/11	12"-1030
2/18	dreg 1875
2/25	" 2395
3/4	" 2575'
3/11	" 2725'
	Top Chat 2969
	TD. 2973 Run 6"

3/18-

HFW at 3005

T.D. 3032

Dry & Abandon

Harvey
 Map No. KANSAS Sec. 26 Twp. 22 R. 2W
 Well No. 1 Lehmann

Jones & Shell Oil Co. Company

Contractor

SECTION PLAT

0			

660 Ft. from N. Line

..... Ft. from S. Line

..... Ft. from E. Line

660 Ft. from W. Line

FIRST REPORTS

Location ✓

Rig up

Drilling and Remarks:

RECORD

Cased.....in.,ft.

Sand.....

Gas.....

Oil.....

Total Depth.....

PRODUCTION

1st 24 hrs. Nat.....

1st 24 hrs. after shot.....

Gas.....Cu. Ft.

Dry Hole.....

Abandoned.....

Date

NOV 5 1930 S. J. LEWIS Scout

Map No. KANSAS Sec. 36 Twp. 22 R. 2 W

Well No. 1-12 hman

Jones & Shell P & C Company

Contractor

SECTION PLAT


660 Ft. from N. Line

..... Ft. from S. Line

..... Ft. from E. Line

660 Ft. from W. Line

ABANDONED

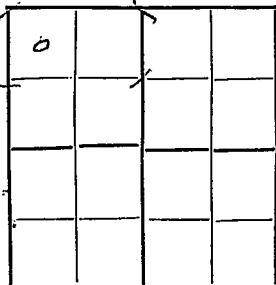

Location.....

Rig up.....

Drilling and Remarks:

4 FX 3005

RECORD

Cased.....in.,ft.

Sand.....

Gas.....

Oil.....

Total Depth 3032

PRODUCTION

1st 24 hrs. Nat.....

1st 24 hrs. after shot.....

Gas.....Cu. Ft.

Dry Hole.....

Abandoned.....

Date

MAR 18 1931₉₂

S. J. LEWIS Scout