

Map No. KANSAS Sec. 36 Twp. 22 R. 7^w

Well No. 1-300 Farm _____

Texas Co Company _____

665

~~330~~ Ft. from N. Line

_____ Ft. from S. Line


664

~~990~~ Ft. from E. Line

_____ Ft. from W. Line

1930

NORTH

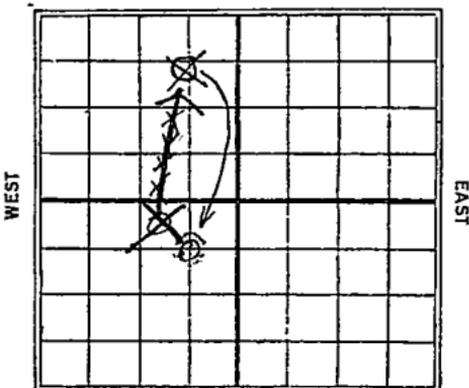

Date

REPORT

Date	REPORT
8/6	Cellar
8/13	Roll.
8/20	Bldg rig
8/27	Rign up.
9/3	Spud
9/10	15"-480' dry.
9/17	dry 1130'
9/24	" 1735'
10/1	Spa. out 1875'
10/8	Fly tools 2120'
10/15	Dry 2350'
10/22	" 2530'
10/29	HFW at 2670
	S/R 8"- to 2700'
11/5	Dry 2810'
11/12	Top Chat 2982'
	show oil 3004'
	7/700 3009' - Dry.
	3080'
11/19	dry 3150'
11/20	J.D. 3240' S.D.
12/13	Dry 3350'

12/10- Dry 3455

12/17- HFW at 3510
Dry 3540

12/23- Wilcox 3500' HFW
Tide time 3537
TD. 3550

Dry & Abandon

Map No. KANSAS Sec. 36 Twp. 22 R. 2W

Well No. 12006

St. Paul Oil Company

Contractor

SECTION PLAT

330 Ft. from N. Line

_____ Ft. from S. Line

990 Ft. from E. Line

_____ Ft. from W. Line

	0		

FIRST REPORTS :

Location _____

Rig up _____

Drilling and Remarks:

Cellar

RECORD

Cased _____ in., _____ ft.

Sand _____

Gas _____

Oil _____

Total Depth _____

PRODUCTION

1st 24 hrs. Nat. _____

1st 24 hrs. after shot _____

Gas _____ Cu. Ft.

Dry Hole _____

Abandoned _____

Date

AUG 6 1930

S. J. LEWIS Scout

Harvey

Map No. KANSAS Sec. 36 Twp. 22 R. 2 W

Well No. 43 1900k.

Texas Oil

Company

Contractor


SECTION PLAT

665 Ft. from N. Line

_____ Ft. from S. Line

664 Ft. from E. Line

_____ Ft. from W. Line

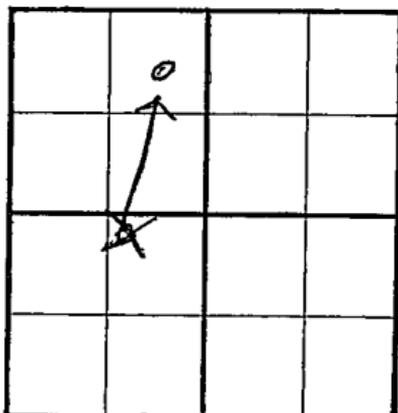

CORRECTION

Location _____

Rig up _____

Drilling and Remarks:

*Reported
No. NE 391.*

RECORD

Cased _____ in., _____ ft.

Sand _____

Gas _____

Oil _____

Total Depth _____

PRODUCTION

1st 24 hrs. Nat. _____

1st 24 hrs. after shot _____

Gas _____ Cu. Ft.

Dry Hole _____

Abandoned _____

Date

SEP 3 1930

S. J. LEWIS

Scout

Map No. **KANSAS** Sec. 36 Twp. 22 R. 2W

Well No. 1

Texas Oil Company

Contractor

SECTION PLAT

665 Ft. from N. Line

..... Ft. from S. Line

664 Ft. from E. Line

..... Ft. from W. Line

	0		

CORRECTION

Location.....

Rig up.....

Drilling and Remarks:

*Should be
center NE SW.
& not center
NE NW.*

RECORD

Cased..... in., ft.

Sand.....

Gas..... "

Oil.....

Total Depth.....

PRODUCTION

1st 24 hrs. Nat.....

1st 24 hrs. after shot.....

Gas..... Cu. Ft.

Dry Hole.....

Abandoned.....

Date

DEC 23 1930

192

S. J. LEWIS

Scout

Map No. **KANSAS** Sec. 36 Twp. 22 R. 2W

Well No. 13002

Texas Oil Company

Contractor

"**ABANDONED**"


SECTION PLAT

665 Ft. from N. Line

..... Ft. from S. Line

664 Ft. from E. Line

..... Ft. from W. Line

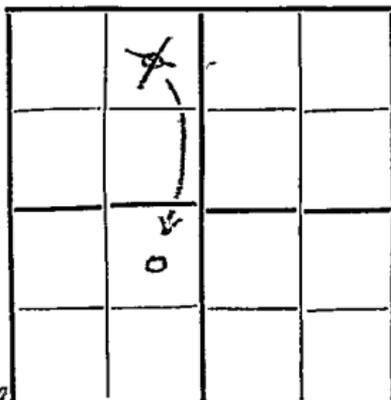

COMPLETED

CORRECTION *of location.*

Location.....

Rig up.....

Drilling and Remarks:

*Well 3500 NW
Oil line 3537*

RECORD

Cased..... in., ft.

Sand.....

Gas.....

Oil.....

Total Depth 3550

PRODUCTION

1st 24 hrs. Nat.....

1st 24 hrs. after shot.....

Gas..... Cu. Ft.

Dry Hole.....

Abandoned 3550

Date

DEC 23 1930

S. J. LEWIS

Scout