


Map No. KANSAS Sec. 36 Twp. 22 R. 2^w
 Well No. McPherson 0912 Farm Palmer
 Company

NORTH

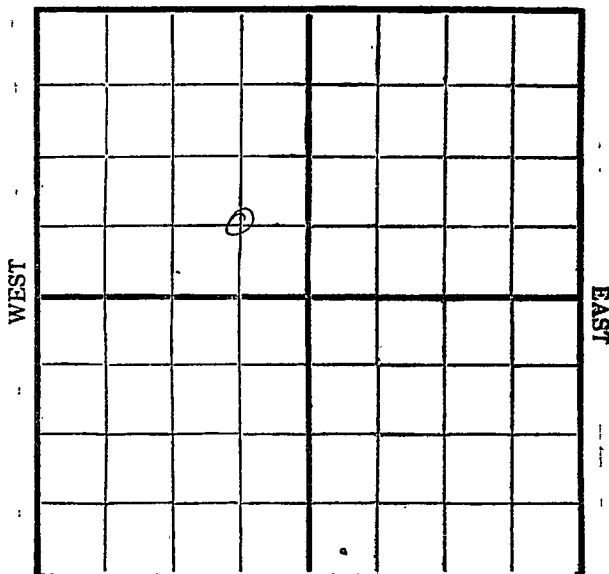

SOUTH

Location _____

Drilling Remarks

Rig Up _____

Drilling Remarks

RECORD

Cased _____ in. _____ ft.

Sand _____

Gas _____

Oil _____

Total Depth _____

PRODUCTION

1st 24 hrs. Nat. _____

1st 24 hrs. after shot _____

Gas _____ cu. ft.

Dry Hole _____

Abandoned _____

Harvey
 Map No. KANSAS Sec. 36 Twp. 22 R. 2^w
 Well No. 1 - Palmer Farm
M^e Pherson O & G Company

NORTH

Ft. from N. Line

660 Ft. from S. Line

660 Ft. from E. Line

Ft. from W. Line

WEST

EAST

SOUTH

Date

REPORT

2/5	Root
2/12	Run up
2/19	Spud
2/26	Calg. 695.
3/5	" 1520'
3/12	" 1965'
3/19	" 2490'
3/26	U/R 8" - 2705'
4/2	Orlg 2805'
4/9	Top Chat 2970
	Pay 2997 - 3002
	T.D. - flowed 3150 bbls.
	24 hours - Shut 3%
4/16	T.D. 3002 - Flowed
	291 bbls 24 hrs -
	Shut 1/2%
4/23	Chat 2970 - 3002
	TD 3002
	swab 240 bbl oil
	33# g/lao
	Somp.

Harvey
 Map No. KANSAS Sec. 36 Twp. 22 R. 2W
43
 Well No. Palmer

M. P. Person O & G Company

Contractor

SECTION PLAT

_____ Ft. from N. Line

660 Ft. from S. Line

660 Ft. from E. Line

_____ Ft. from W. Line

FIRST REPORTS

Location _____

Rig up _____

Drilling and Remarks:

ROG

RECORD

Cased _____ in., _____ ft.

Sand _____

Gas _____

Oil _____

Total Depth _____

PRODUCTION

1st 24 hrs. Nat. _____

1st 24 hrs. after shot _____

Gas _____ Cu. Ft.

Dry Hole _____

Abandoned _____

Date

FEB 5 1930
192

S. J. LEWIS Scout

Harvey
Map No. KANSAS Sec. 36 Twp. 22 R. 2W

Well No. 43 Palmer

McPherson Oil Co. Company

Contractor

SECTION PLAT

.....Ft. from N. Line

660 Ft. from S. Line

660 Ft. from E. Line

.....Ft. from W. Line

	o		

CORRECTION -

Location.....

Rig up.....

Drilling and Remarks:

Reported in

36-22-SW

(First report shows)
36-22-2W

Run

Date

RECORD

Cased.....in.,ft.

Sand.....

Gas.....

Oil.....

Total Depth.....

PRODUCTION

1st 24 hrs. Nat.....

1st 24 hrs. after shot.....

Gas.....Cu. Ft.

Dry Hole.....

Abandoned.....

FEB 12 1930

192

Scout

Harvey
 Map No. **KANSAS** Sec. **36** Twp. **22** R. **2W**
43
 Well No. **Palmer**

McPherson Oil & Gas Company

Contractor

SECTION PLAT

	0		

Ft. from N. Line

660 Ft. from S. Line

660 Ft. from E. Line

Ft. from W. Line

COMPLETED

Location

Rig up

Drilling and Remarks:

Chas 2970 - 3002

2100 ft 240 ft
33.7 Gravity

Spill in operation

RECORD

Cased **2** in., **2** ft.

Sand

Gas

Oil

Total Depth **3002**

PRODUCTION

1st 24 hrs. Nat.

1st 24 hrs. after shot

Gas **2** Cu. Ft.

Dry Hole

Abandoned

Date

APR 23 1930

192

S. J. LEWIS Scout