


Map No. KANSAS Sec. 36 Twp. 22 R. 2^w

Well No. 1-300k Farm Washoma & Shell Company

NORTH

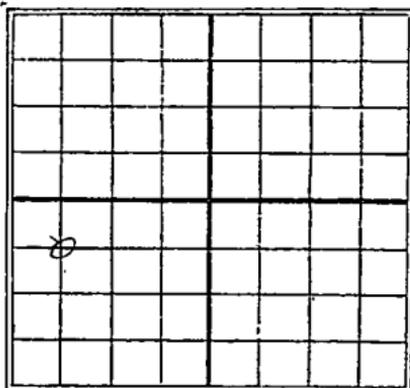

660 Ft. from N. Line

_____ Ft. from S. Line

_____ Ft. from E. Line

660 Ft. from W. Line

1930

Date REPORT

Date	REPORT
9/10	Loc
9/17	Cellar
9/24	R.O.S.
10/1	Rig
10/18	—
10/15	—
10/22	Ran up
10/29	Speed
11/5	" 190'
11/12	hdlg. 860'
11/19	" 1416'
11/25	" 1930'
12/3	" 2105'
12/10	8" 2490'
	Drig 2510'
12/17	TD 2590'
	8" casy collapsed
12/23	Drig 2750'
12/30	6"-2781'
	Drig 2790'
	(over)

1931

1/17- Chat ~~2975~~ 2965

Drig ahead

1/14- VIR 6th 2975

1/21- Chat 2965' (SWM)

Show gas 2976-77

SD. 2982' T.D.

1/28- Oil 2989

TD. 2993 tubing

Have 1000' fluid

2/4- T.D. 2993

Pump 32 bbl oil & water

in 24 hrs.

2/11- T.D. 2993

Pump 5 bbl oil and

5 bbl water 24 hr

2/18- T.D. 3000'

flow 64 2 1/2 bbl 10 1/2 hrs

3 1/4 % water

Grav. 34 1/2

2/25- Chat 2965-3000

TD. 3000

Pump 734 bbl

3% water
Comp.

Map No. KANSAS Sec. 36 Twp. 22 R. 2W

Well No. 1 good

W. H. Thomas & Shell Company

Contractor

SECTION PLAT

660 Ft. from N. Line

..... Ft. from S. Line

..... Ft. from E. Line

660 Ft. from W. Line

FIRST REPORTS

Location

Rig up

Drilling and Remarks:

RECORD

Cased..... in., ft.

Sand.....

Gas.....

Oil.....

Total Depth.....

PRODUCTION

1st 24 hrs. Nat.....

1st 24 hrs. after shot.....

Gas..... Cu. Ft.

Dry Hole.....

Abandoned.....

Date

SEP 10 1930

S. J. LEWIS

Scout

43

Map No. KANSAS Sec. 36 Twp. 22 R. 2W

Well No. 9006

Wichita & Shell Company

Contractor

SECTION PLAT

660 Ft. from N. Line

..... Ft. from S. Line

..... Ft. from E. Line

660 Ft. from W. Line

COMPLETED

Location.....

Rig up.....

Drilling and Remarks:

*Pump 734 88 h.
3% Water*

RECORD

Cased..... in., ft.

Sand 2965-3000

Gas.....

Oil.....

Total Depth 3000

PRODUCTION

1st 24 hrs. Nat.....

1st 24 hrs. after shot.....

Gas..... Cu. Ft.

Dry Hole.....

Abandoned.....

Date

FEB 25 1931

J. LEWIS Scout