

# KANSAS

FORM 51 5M 10-41 PETROL


Reno

Section 36 Township 22 Range 10-W

Well No. #1 Wisby

Company Transwestern

NORTH Peace Creek Pool

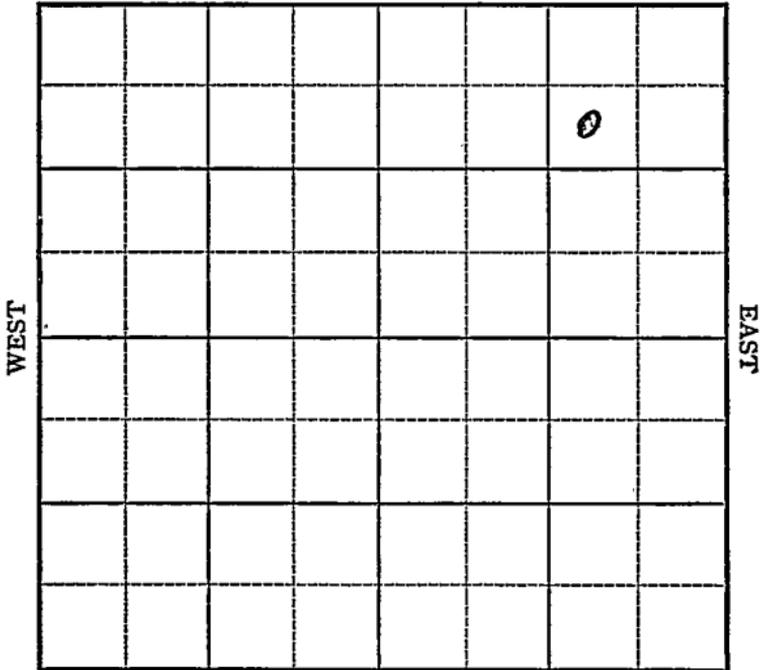

SOUTH

Sec. 36 Twp. 22 R. 10-W

Well No. #1 Wisby Farm

Transwestern Company


(Peace Creek)

990 Ft. from N. Line

Ft. from S. Line

990 Ft. from E. Line

Ft. from W. Line

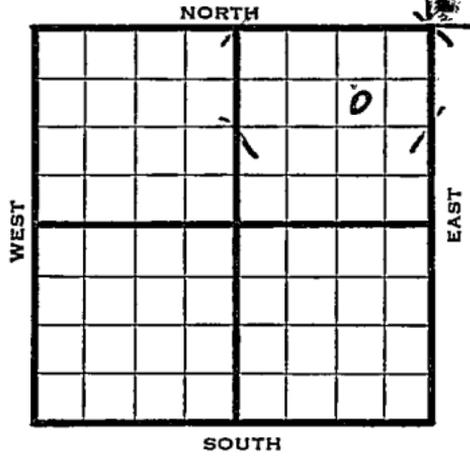

1942

REPORT


7/1	Location
7/8	"
7/15	Location abandoned.

ABANDONED

Map No. 46 Sec. 36 Twp. 22 R. 10WWell No. 1 WisbyTranswestern CompanyFIRST REPORT Contractor

S W N E N E

## SECTION PLAT

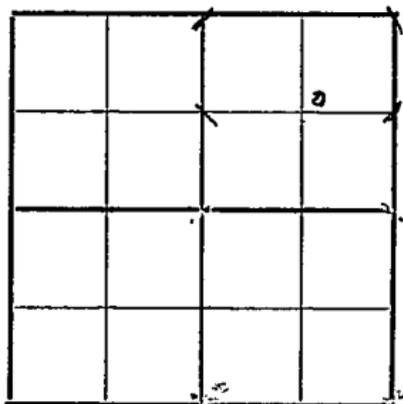990 Ft. from N. Line       Ft. from S. Line990 Ft. from E. Line       Ft. from W. Line

PEACE CREEK POOL

Location XXXRig up       

Drilling and Remarks:

## RECORD

Cased        in.,        ft.Sand       Gas       Oil       Total Depth       

## PRODUCTION

1st 24 hrs. Nat.       1st 24 hrs. after shot       Gas        Cu. Ft.Dry Hole       Abandoned       

Date

JUL 1 1942

S. J. LEWIS

Scout

