


Section 36 Township 22 Range 3W

Well No. #1 Goering

Company Springer & Harper

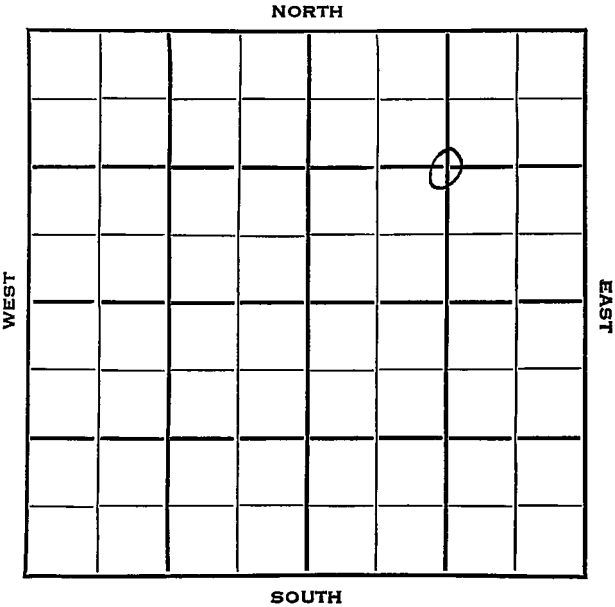

Harvey KANSAS

Sec. 36 Twp. 22 R. 3W ✓Well No. #1 Goering FarmSpringer & Harper CompanySpringer & Harper Contractor

Wall Pool


1320 Ft. from N. Line

Ft. from S. Line

1320 Ft. from E. Line

Ft. from W. Line

C NE/4

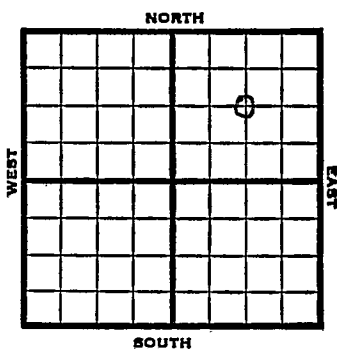

1953

Elev. 1417' REPORT

8/12

Spud 7-28-53
 8" @ 283
 Anhy 365
 Lans 2445
 Miss 3152, Miss Lime 3154
 TD 3155
 5" @ 3155, WOC

8/19

WOC

8/26

"

9/2

"

9/16

"

9/30

D & A

10/14

"

10/21


"

10/28

Spud 7-28-53 D & A TD 3248
 8" @ 283 Anhy 365 Lans 2445
 Miss 3152' Miss. lm. 3154
 TD 3155 5" @ 3155 DD 3190
 DD 3204 DD 3248 HFW PB 3198
 24/3150-55 2000 A
 D & A

ABANDONED

County Harvey State Kansas
 Sec. 36 (Blk. 22) (Sur. 3W) Map No.
 Operator Springer & Harper
 Well No. 1 Farm Goering
 Elev. 1417 Location C NE/4

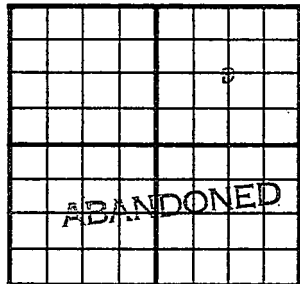

1320 Ft. From N Line NE

1320 Ft. From E Line Quarter

1st. Report

Completion OCT 28 1953

Remarks Wall Pool
Springer & Harper - Contr.

Spudding Date 7-28-53

Drilg. Data D & A TD 3248

8" @ 283 Anhy 365 Lans. 2445

Miss. 3152 Miss. lm. 3154 TD 3155

5" @ 3155 DD 3190 DD 3204 DD 3248

HFW PB 3198 24/ 3150-55 2000 A

D & A