


Reno

Form 51-5M-11-31-Palace

Map No. **KANSAS** Sec. **36** Twp. **22** R. **4W**

Well No. **1 Bartel** Farm
Manning & Terry Company

NORTH

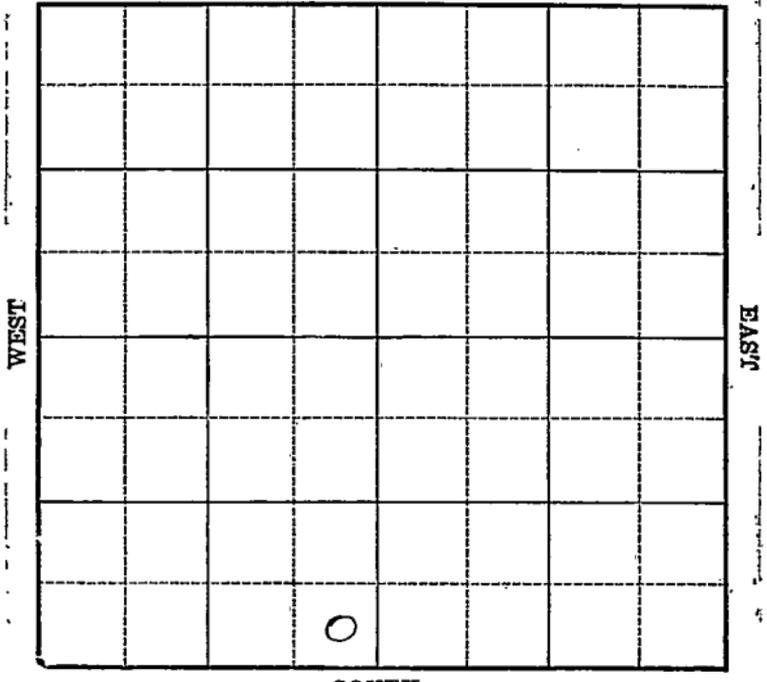

O. W. D. D

Location _____

Drilling Remarks _____

Rig Up _____

Drilling Remarks _____

RECORD

Cased _____ in. _____ ft.

Sand _____

Gas _____

Oil _____

Total Depth _____

PRODUCTION

1st 24 hrs. Nat. _____

1st 24 hrs. after shot _____

Gas _____ cu. ft.

Dry Hole _____

Abandoned _____

Reno

Map No. KANSAS Sec. 36 Twp 22 R. 4W

Well No. 1- Bartel Farm


Manning-Terry Company

_____ Ft. from N. Line

340 Ft. from S. Line

209 Ft. from E. Line

_____ Ft. from W. Line

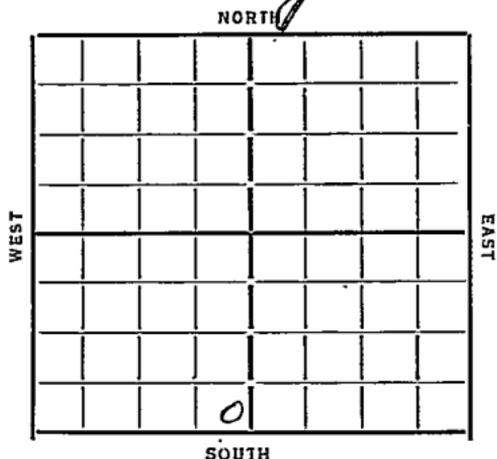

Date 1934

REPORT

O. W. D. D

1/24	Reg up		
1/31	15 1/2" 297 WOC		
2/7	Fishy. 1415		
2/14	Drly 2151		
2/23	" 2809	WEL 2530	
3/1	" 3040		
3/8	Chat 3241	8" 3252	Rust
3/15	Bailing		
3/22	3260 1/2 W Has	2950'	fluid
	3336-40	Bailing	
3/29	—		
4/5	2D temporarily		
4/12	—	4/19	— 6/26 —
5/3	—	5/10	— 5/18 —
5/25	—	5/31	— 6/7 —
6/4	—	6/21	— 6/28 —
7/5	—	7/12	— 7/19 —
7/26	—	8/2	— 8/9 —
8/6	—	8/23	— 8/30 —
9/6	—	9/13	— 9/20 —
9/27	—	10/4	— 10/11 — 10/18 —
10/25	—	11/1	— 11/8 — 11/15 —
			— OVER —

11/22 3340 57 temporarily
11/28 — 12/6 — 12/13 — 12/21 —
12/27 — 1/3/35 — 1/10 —
1/16 abandoned 3340.

ABANDONED

1935 O. W. D. D
3/6 Rgn to deepen.
3/14 Rly 3468
3/20. Hunter 3626 T 17 3646
A + A.

ABANDONED

Map No. 48 Sec. 36 Twp. 22 R. 4W

Well No. 1- Bartel

Manning & Terry Company

Contractor

COMPLETED
ABANDONED

SECTION PLAT

.....Ft. from N. Line

340 Ft. from S. Line

209 Ft. from E. Line

.....Ft. from W. Line

ABANDONED

Location.....

Rig up.....

Drilling and Remarks:

Abandoned

RECORD

Cased.....in.,ft.

Sand.....

Gas.....

Oil.....

Total Depth 3340

PRODUCTION

1st 24 hrs. Nat.....

1st 24 hrs. after shot.....

Gas.....Cu. Ft.

Dry Hole.....

Abandoned.....

Date

ORVAL MANNSCHRECK

1-16-35 192.....

Scout

Map No. 48 Sec. 36 Twp. 22 R. 4W

Well No. 1- Bartel

Manning & Terry Company
Contractor

FIRST REPORTS

..... Ft. from N. Line
340 Ft. from S. Line
209 Ft. from E. Line
..... Ft. from W. Line

SECTION PLAT

Location.....
Rig up
Drilling and Remarks:

RECORD

Cased..... in., ft.
Sand.....
Gas.....
Oil.....
Total Depth.....

PRODUCTION

1st 24 hrs. Nat.....
1st 24 hrs. after shot.....
Gas..... Cu. Ft.
Dry Hole.....
Abandoned.....

Date

12-4-34 192 O. Mannschreck Scout

Map No. 48 Sec. 36 Twp. 22 R. 4 W

Well No. 1 - Bartel

Manning + Terry Company

Contractor

FIRST REPORTS

..... Ft. from N. Line

340 Ft. from S. Line

209 Ft. from E. Line

..... Ft. from W. Line

OWND

SECTION PLAT

Location.....

Rig up.....

Drilling and Remarks:

OTN 3340

RECORD

Cased..... in., ft.

Sand.....

Gas.....

Oil.....

Total Depth.....

PRODUCTION

1st 24 hrs. Nat.....

1st 24 hrs. after shot.....

Gas..... Cu. Ft.

Dry Hole.....

Abandoned.....

Date

3-6-35

192

ORVAL MANNSCHRECK

Scout

Map No. 48 Sec. 36 Twp. 22 R. 4W

Well No. 1-Bartel

Manning & Terry Company

Contractor

ABANDONED

SECTION PLAT

.....Ft. from N. Line

340 Ft. from S. Line

209 Ft. from E. Line

.....Ft. from W. Line

Location.....

Rig up.....

Drilling and Remarks:

10 + FT

RECORD

Cased.....in.....ft.

Sand Hunton 3626

Gas.....

Oil.....

Total Depth 3646

PRODUCTION

1st 24 hrs. Nat.....

1st 24 hrs. after shot.....

Gas.....Cu. Ft.

Dry Hole.....

Abandoned.....

Date

3-20-35 192

ORVAL MANSCHRECK Scout