


Section 36 Township 22 Range 4-W

Well Number #2 ~~#5~~-Bartel

Company F. Hollow & Carter

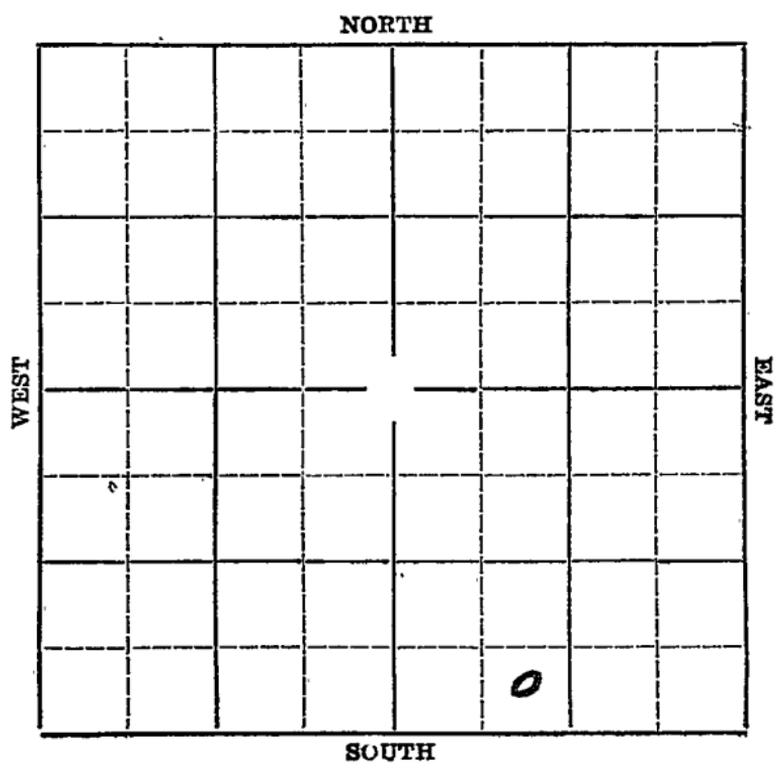

Map No. KANSAS Sec. 36 Twp. 22 R. 4W

Well No. ~~#3 Bartel~~ #2 Bartel Farm

F. Hollow & Carter Company


_____ Ft. from N. Line

330' Ft. from S. Line

_____ Ft. from E. Line

990' Ft. from W. Line

Elev. 1451

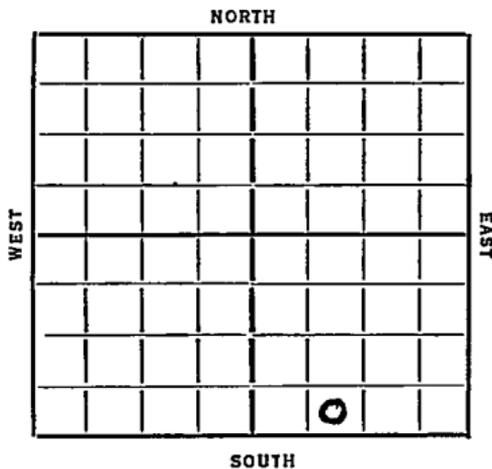

1936

REPORT

7/1 Rig.

7/9 Drlg. 1550'.

7/16 Drlg. 2760'.

7/23 ~~Chat~~ Chat 3253'. 7" @ 3272'. 3280'.

Rigging up standard tools.

7/30 --

8/6 Gas 3295'. Oil 3328-34'. Oil 3339-44'. Show water 3344-46'. Plug back 6334'. 2000 gallons of acid. No tes

8/13 Pump 131 bbls of oil and 25 bbls of water in 24 hours.

8/20 No test.

8/26/36 Chat 3253'. T.D. 3347'.

5000 gallons of acid.

Potential 217 bbls of oil and 75 bbls of water pump and flow.

COMPLETED

Map No. 48 Sec. 36 Twp. 22 R. 4W

Well No. 3 Bartsch

H. H. Snow & Carter Company

Contractor

SECTION PLAT

_____ Ft. from N. Line

330 Ft. from S. Line

_____ Ft. from E. Line

990 Ft. from W. Line

FIRST REPORT

Location _____

Rig up _____

Drilling and Remarks:

Rig

RECORD

Cased _____ in., _____ ft.

Sand _____

Gas _____

Oil _____

Total Depth _____

PRODUCTION

1st 24 hrs. Nat. _____

1st 24 hrs. after shot _____

Gas _____ Cu. Ft.

Dry Hole _____

Abandoned _____

Date

Jul 1 1936

Scout

Map No. 48 Sec. 36 Twp. 22 R. 4W

Well No. 2 Bartel

E. A. Lloyd & Carter Company

Contractor

SECTION PLAT

_____ Ft. from N. Line

330 Ft. from S. Line

_____ Ft. from E. Line

990 Ft. from W. Line

CORRECTION

Location _____

Rig up _____

Drilling and Remarks:

*Refr. to today
No 9*

RECORD

Cased _____ in., _____ ft.

Sand _____

Gas _____

Oil _____

Total Depth _____

PRODUCTION

1st 24 hrs. Nat. _____

1st 24 hrs. after shot _____

Gas _____ Cu. Ft.

Dry Hole _____

Abandoned _____

Date

AUG 26 1936 19

S. J. LEWIS

Scout

KANSAS

Map No. _____ Sec. 36 Twp. 22 R. 4W

Well No. 2 Bartel

E. Walker & Coartel Company

Contractor

SECTION PLAT

100 Ft. from N. Line

330 Ft. from S. Line

_____ Ft. from E. Line

990 Ft. from W. Line

COMPLETED

Location _____

Rig up _____

Drilling and Remarks:

04a 83253
5000 acid
Pa 8217 oil
75 Water
Pump & Blow

RECORD

Cased _____ in., _____ ft.

Sand _____

Gas _____

Oil _____

Total Depth 3347

PRODUCTION

1st 24 hrs. Nat. _____

1st 24 hrs. after shot _____

Gas _____ Cu. Ft.

Dry Hole _____

Abandoned _____

Date

AUG 26 1936 19

S. J. LEWIS

Scout